

*Development Corp*  
*184 # Garrisonville Road*  
*Stafford, Va. 22556*  
*720-6075 F 720-3110*

Commonwealth of Virginia  
 Uniform Water Well Completion Report

Owner Leah's read association  
 Address \_\_\_\_\_

Tax Map ID 25A-26  
 VDH Permit SWP-95-39  
 VWCB Permit \_\_\_\_\_  
 VWCB ID \_\_\_\_\_  
 County STAFFORD  
2/22/95 Daniel J. [unclear]  
DJC

Phone \_\_\_\_\_  
 Location Stone House Wooded Est. #26  
184 # Garrisonville Road  
 Well Classification IIIA IIIB ✓ IIIC IV  
Approx 2 1/2 A. West of 7612 \* Well Data \*  
1/2 A. West of 7612

General Information  
 Drilling Method Air Rotary  
 Depth to Bedrock 56  
 Static Water Level 40  
 Well Disinfected (Y or N) \_\_\_\_\_

Date Completed 9/1/95  
 Yield 20 (GPM)  
 Stabilized Water Level 80'  
 Disinfectant Used \_\_\_\_\_

Total Depth of Well 200  
 Length of Test approx 1 Hr.  
 Natural Flow (Rate) \_\_\_\_\_  
 Amount Used \_\_\_\_\_

Casing  
 From 1 To 71  
 Size 6 1/4" Material P.V.C.  
 Weight/Schedule SDR 27

From 60 To 160  
 Size 4" Material P.V.C.  
 Weight/Schedule Sch 40

From 180 To 200  
 Size 4" Material P.V.C.  
 Weight/Schedule Sch 40

Gravel Pack  
 From \_\_\_\_\_ To \_\_\_\_\_

From \_\_\_\_\_ To \_\_\_\_\_  
 Hole size 1 1/8" from 71 to 200 ft.

From \_\_\_\_\_ To \_\_\_\_\_  
 Hole size \_\_\_\_\_ from \_\_\_\_\_ to \_\_\_\_\_ ft.

Grout  
 From 0 To 50 1/4  
 Bore Hole Size 10"  
 Type Bentonite  
 Method Pressure Grouting

From \_\_\_\_\_ To \_\_\_\_\_  
 Bore Hole Size \_\_\_\_\_  
 Type \_\_\_\_\_  
 Method \_\_\_\_\_

From \_\_\_\_\_ To \_\_\_\_\_  
 Bore Hole Size \_\_\_\_\_  
 Type \_\_\_\_\_  
 Method \_\_\_\_\_

Water Zones or Screened Intervals  
 From 160 To 180  
 Mesh Size .020 Diam 4" (P.V.C.)  
 From \_\_\_\_\_ To \_\_\_\_\_  
 Mesh Size \_\_\_\_\_ Diam \_\_\_\_\_

approx water zones  
 From 120 To 121  
 Mesh Size \_\_\_\_\_ Diam \_\_\_\_\_  
 From 170 To 171  
 Mesh Size \_\_\_\_\_ Diam \_\_\_\_\_

From \_\_\_\_\_ To \_\_\_\_\_  
 Mesh Size \_\_\_\_\_ Diam \_\_\_\_\_  
 From \_\_\_\_\_ To \_\_\_\_\_  
 Mesh Size \_\_\_\_\_ Diam \_\_\_\_\_

\* Use Data \*

Private Well: Domestic  Agricultural \_\_\_\_\_ Industrial \_\_\_\_\_ Monitoring \_\_\_\_\_  
 Public Well: Community \_\_\_\_\_ Non Community \_\_\_\_\_

\* Abandonment Information \*

Bored or Dug Wells  
 Casing Removed, Y or N?: \_\_\_\_\_  
 If Y, Depth to which casing was removed: \_\_\_\_\_  
 Depth and Type of Fill: \_\_\_\_\_  
 Source of Fill \_\_\_\_\_  
 Bentonite Plugs: From \_\_\_\_\_ to \_\_\_\_\_ From \_\_\_\_\_ to \_\_\_\_\_

Wells other than Bored Wells  
 Casing removed, Y or N? \_\_\_\_\_  
 Depth to which casing was removed: \_\_\_\_\_  
 Applicable, depth(s), and type of gravel/sand fill: \_\_\_\_\_  
 Source of gravel or sand: \_\_\_\_\_  
 Cement: From \_\_\_\_\_ to \_\_\_\_\_ From \_\_\_\_\_ to \_\_\_\_\_

Method of permanently marking location: \_\_\_\_\_

Installed watertight top  
 Suggest setting pump @ approx 100 ft.  
You will encounter 4" casing @ approx 60 ft.  
Suggest keeping torque arrestors & centralizers out of 4" casing  
950592


State Department  
Electric

Hanson Development Corp  
Stone Tower Wooded Est.  
Stafford  
Meadow Road  
Off 178612

• Drillers Log •

Depth Description of Formation or Sediment Remarks

0	10	Red Clay	
10	56	Brown Clay	
56	71	Soft Brown Rock	
71	110	Brown Rock	Set 4" P.V.C. Casing & screen due to the softness of the formation
110	200	Light Gray Rock	

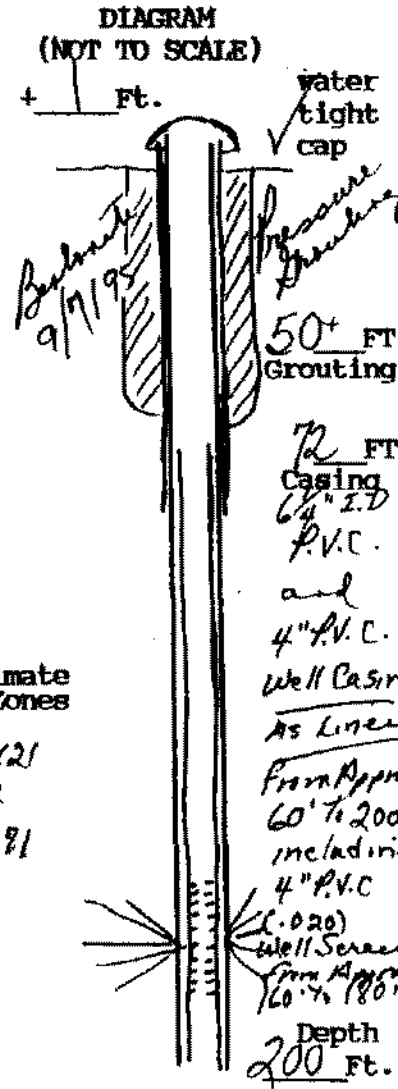

Approximate Water Zones  
120 to 121  
and  
170 to 181

(User additional Sheets if necessary)

I certify that the information contained here is true and that this well was installed and constructed in accordance with the permit and further that the well complies with all applicable state and local regulations, ordinances and laws.

Name JOHN L. DANIELSON, JR., INC.  
Address 4616 HOOD DRIVE  
FREDERICKSBURG, VIRGINIA 22408  
Phone (703) 898-6025 / 898-9355

Drillers Signature John L. Danielson, Pres.  
Date 9/7/95 Representing JOHN L. DANIELSON, JR., INC.

Virginia Contractors License Number CLASS A 2701 014084A H/H WWC