

**Commonwealth of Virginia  
Uniform Water Well Completion Report**

*Agency Name*  
Stafford Va. 22554  
1-59-9987

Permit issued to:  
Owner Chhy Norcross Inc / For Sale  
Address 9716 Harrisonville Rd.  
Stafford Va. 22554  
Phone 720-1892  
Location Cannon Knolls # 37

Tax Map ID 26F-37  
VDH Permit 5-94-48/W-94-61  
WVCB Permit \_\_\_\_\_  
WVCB ID \_\_\_\_\_  
County Stafford  
3/22/94 Ashton B. Wright  
3/25/94 J.J. Thompson

Well Classification IIIA \_\_\_\_\_ IIIB  IIIC \_\_\_\_\_ IV \_\_\_\_\_  
\* Well Data \*

General Information  
Drilling Method Air Rotary  
Depth to Bedrock 79'  
Static Water Level 20'  
Well Disinfected (Y or N) \_\_\_\_\_

Date Completed 7/25/94  
Yield 25 (GPM)  
Stabilized Water Level 120'  
Disinfectant Used \_\_\_\_\_

Total Depth of Well 200  
Length of Test approx 1 Hr.  
Natural Flow (Rate) \_\_\_\_\_  
Amount Used \_\_\_\_\_

Casing  
From +1 to 79  
Size 6 1/4" Material P.V.C.  
Weight/Schedule SDR 27

From \_\_\_\_\_ To \_\_\_\_\_  
Size \_\_\_\_\_ Material \_\_\_\_\_  
Weight/Schedule \_\_\_\_\_

From \_\_\_\_\_ To \_\_\_\_\_  
Size \_\_\_\_\_ Material \_\_\_\_\_  
Weight/Schedule \_\_\_\_\_

Gravel Pack  
From \_\_\_\_\_ To \_\_\_\_\_  
Hole size  
10" from 0 to 60 ft.  
Grout  
From 0 to 50'  
Bore Hole Size 10" 7/29/94  
Type Bentonite  
Method Pressure Grouting

From \_\_\_\_\_ To \_\_\_\_\_  
7 7/8" from 60 to 79 ft.  
From \_\_\_\_\_ To \_\_\_\_\_  
Bore Hole Size \_\_\_\_\_  
Type \_\_\_\_\_  
Method \_\_\_\_\_

From \_\_\_\_\_ To \_\_\_\_\_  
6 1/8" from 79 to 200 ft.  
From \_\_\_\_\_ To \_\_\_\_\_  
Bore Hole Size \_\_\_\_\_  
Type \_\_\_\_\_  
Method \_\_\_\_\_

Water Zones or Screened Intervals  
From 180 To 181  
Mesh Size \_\_\_\_\_ Diam \_\_\_\_\_  
From \_\_\_\_\_ To \_\_\_\_\_  
Mesh Size \_\_\_\_\_ Diam \_\_\_\_\_

From \_\_\_\_\_ To \_\_\_\_\_  
Mesh Size \_\_\_\_\_ Diam \_\_\_\_\_

\* Use Data \*

Private Well: Domestic  Agricultural \_\_\_\_\_ Industrial \_\_\_\_\_ Monitoring \_\_\_\_\_  
Public Well: Community \_\_\_\_\_ Non Community \_\_\_\_\_

\* Abandonment Information \*

Bored or Dug Wells  
Casing Removed, Y or N? \_\_\_\_\_  
If Y, Depth to which casing was removed: \_\_\_\_\_  
Depth and Type of Fill: \_\_\_\_\_  
Source of Fill \_\_\_\_\_  
Bentonite Plugs: From \_\_\_\_\_ to \_\_\_\_\_ From \_\_\_\_\_ to \_\_\_\_\_

Wells other than Bored Wells  
Casing removed, Y or N? \_\_\_\_\_  
Depth to which casing was removed: \_\_\_\_\_  
Applicable, depth(s), and type of gravel/sand fill: \_\_\_\_\_  
Source of gravel or sand: \_\_\_\_\_  
Cement: From \_\_\_\_\_ to \_\_\_\_\_ From \_\_\_\_\_ to \_\_\_\_\_

Method of permanently marking location:  
 Installed watertight top  
Suggest setting pump @ approx. 140 ft.


MID-N  
ON DIETARY  
WYLAB ID NO

Rick Ashby  
Ashby Homes  
Cannon Krolls #37  
Stafford

• Drillers Log •

Depth	Description of Formation or Sediment	Remarks
0   10	Red Clay	
10   30	Micaceous formation / Red	
30   65	Micaceous formation / Brown	
65   79	Soft Brown Shale	
79   200	Blue Granite	

DIAGRAM  
(NOT TO SCALE)

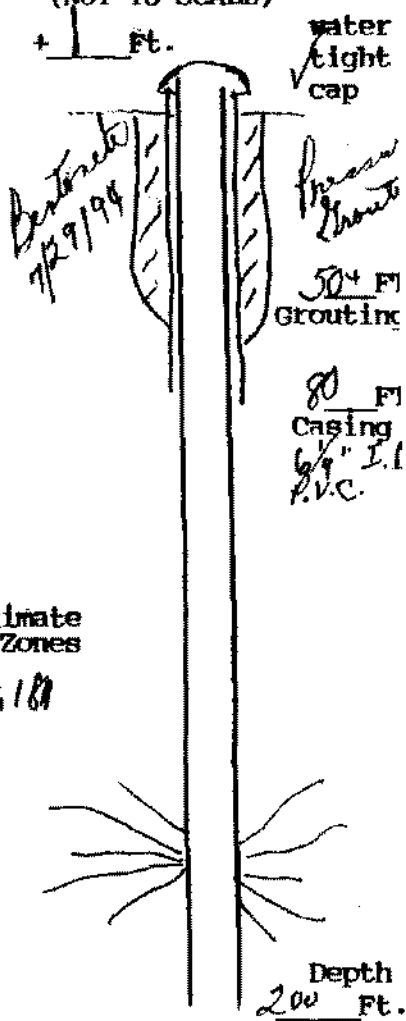

Approximate  
Water Zones  
180 to 189

(User additional Sheets if necessary)

I certify that the information contained here is true and that this well was installed and constructed in accordance with the permit and further that the well complies with all applicable state and local regulations, ordinances and laws.

Name JOHN L. DANIELSON, JR., INC.  
Address 4616 HOOD DRIVE  
FREDERICKSBURG, VIRGINIA 22408  
Phone (703) 898-6025 / 898-9355

Drillers Signature [Signature]  
Date 7/29/94 Representing JOHN L. DANIELSON, JR., INC.

Virginia Contractors License Number CLASS A 2701 014084A H/H WNC