

Commonwealth of Virginia

Uniform Water Well Completion Report

2661-2

Owner: Siga Associates
Address: 7101 Park Ave. Manassas, Va. 20110-4350
Phone: 703-330-1212

Tax Map ID: 2661-2
VDH Permit: SWP-96-275
VWCB Permit: _____
VWCB ID: _____
County: Stafford
8/12/96 Rob Snydon

Location: Laurellet Estates #2
183A
Well Classification: IIIA, IIIB, IIIC, IV
approx. 1/10 M. North of Inter 612 & 662 * Well Data *
2/10 M. East of 612

General Information
Drilling Method: Air Rotary
Depth to Bedrock: 35'
Static Water Level: 25'
Well Disinfected (Y or N): _____

Date Completed: 12/5/96
Yield: 134 (GPM)
Stabilized Water Level: 38'
Disinfectant Used: _____

Total Depth of Well: 455
Length of Test: approx 1 Hr
Natural Flow (Rate): _____
Amount Used: _____

Casing
From: +1 To: 85'
Size: 6 1/4" Material: P.V.C.
Weight/Schedule: SDR 27

From: _____ To: _____
Size: _____ Material: _____
Weight/Schedule: _____

From: _____ To: _____
Size: _____ Material: _____
Weight/Schedule: _____

Gravel Pack
From: _____ To: _____

From: _____ To: _____

From: _____ To: _____

Hole size: 10" from 0 to 50 ft.
Grout: _____
From: 0 To: 50'
Bore Hole Size: 10"
Type: Bentonite 9/5/96
Method: Pressure Grouting

7 1/8" from 50 to _____ ft.
From: _____ To: _____
Bore Hole Size: _____
Type: _____
Method: _____

6 1/8" from _____ to _____ ft.
From: _____ To: _____
Bore Hole Size: _____
Type: _____
Method: _____

Water Zones or Screened Intervals
From: 200 To: 201
Mesh Size: _____ Diam
From: 440 To: 441
Mesh Size: _____ Diam

From: _____ To: _____
Mesh Size: _____ Diam
From: _____ To: _____
Mesh Size: _____ Diam

From: _____ To: _____
Mesh Size: _____ Diam
From: _____ To: _____
Mesh Size: _____ Diam

* Use Data *

Private Well: Domestic Agricultural _____ Industrial _____ Monitoring _____
Public Well: Community _____ Non Community _____

* Abandonment Information *

Bored or Dug Wells
Casing Removed, Y or N?: _____
If Y, Depth to which casing was removed: _____
Depth and Type of Fill: _____
Source of Fill: _____
Bentonite Plugs: From _____ to _____ From _____ to _____


Wells other than Bored Wells
Casing removed, Y or N?: _____
Depth to which casing was removed: _____
Applicable, depth(s), and type of gravel/sand fill: _____
Source of gravel or sand: _____
Cement: From _____ to _____ From _____ to _____

Method of permanently marking location:
 Installed watertight top
Suggest setting pump @ approx. 420 ft.

Sig Associates
Sample Cat #2
Stafford
off 6625613
near Center Home Park Drillers Log

Depth Description of Formation or Sediment Remarks

0	10	Red Clay
10	55	Brown Clay
55	85	Brown Shale
85	455	Light Grey Granite

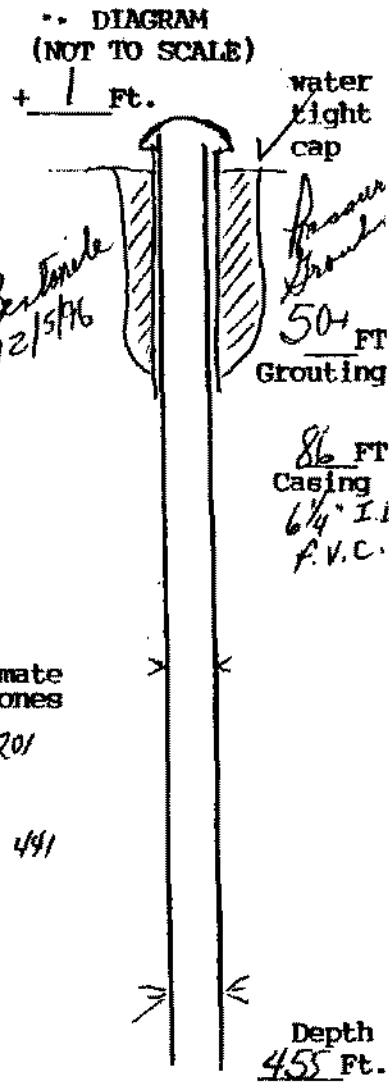

Approximate Water Zones
 206 to 201
 and
 440 to 441

(Use additional Sheets if necessary)

I certify that the information contained here is true and that this well was installed and constructed in accordance with the permit and further that the well complies with all applicable state and local regulations, ordinances and laws.

Name JOHN L. DANIELSON, JR., INC.
 Address 4616 HOOD DRIVE
FREDERICKSBURG, VIRGINIA 22408
 Phone 540 (703) 898-6025 898-9355

Drillers Signature *John L. Danielson, Jr. President*
 Date 12/5/96 Representing JOHN L. DANIELSON, JR., INC.

Virginia Contractors License Number CLASS A 2701 014084A II/II WWC