

Commonwealth of Virginia
 Uniform Water Well Completion Report

Owner Bright Construction / For Sale
 Address 3531 Pappas Rd
Falmouth, VA 22406
 Phone 752-4567
 Location Chester Estates #4 - Rushland Road

Tax Map ID 26-18-4
 VDH Permit SWP-98-162
 VWCB Permit _____
 VWCB ID _____
 County Stafford

Well Classification IIIA _____ IIIB IIIC _____ IV _____
 * Well Data *

SFF

General Information
 Drilling Method Air Rotary
 Depth to Bedrock 88
 Static Water Level 40'
 Well Disinfected (Y or N) _____

Date Completed 8/11/98
 Yield 15 (GPM)
 Stabilized Water Level 180
 Disinfectant Used _____

Total Depth of Well 220'
 Length of Test approx 1 HR
 Natural Flow (Rate) _____
 Amount Used _____

Casing
 From 7 1/4 To 109
 Size 6 1/4 Material P.V.C.
 Weight/Schedule S.D.R. 27

From 100 To 180
 Size 4" Material P.V.C.
 Weight/Schedule Sch. 40

From 200 To 220
 Size 4" Material P.V.C.
 Weight/Schedule Sch. 40

Gravel Pack
 From _____ To _____

From _____ To _____

From _____ To _____

Hole size
10" from 0 to 100 ft.
 Grout
 From 0 To 50'
 Bore Hole Size 10"
 Type Bentonite
 Method Pressure Grouting

_____ " from _____ to _____ ft.
 From _____ To _____
 Bore Hole Size _____
 Type _____
 Method _____

_____ " from _____ to _____ ft.
 From _____ To _____
 Bore Hole Size _____
 Type _____
 Method _____

Water Zones or Screened Intervals
 From 180 To 200
 Mesh Size .016 Diam 4" (P.V.C.)
 From _____ To _____
 Mesh Size _____ Diam _____

approx. water zone
 From 190 To 191
 Mesh Size _____ Diam _____
 From _____ To _____
 Mesh Size _____ Diam _____

From _____ To _____
 Mesh Size _____ Diam _____
 From _____ To _____
 Mesh Size _____ Diam _____

* Use Data *

Private Well: Domestic Agricultural _____ Industrial _____ Monitoring _____
 Public Well: Community _____ Non Community _____

* Abandonment Information *

Bored or Dug Wells
 Casing Removed, Y or N? _____
 If Y, Depth to which casing was removed: _____
 Depth and Type of Fill: _____
 Source of Fill _____
 Bentonite Plugs: From _____ to _____ From _____ to _____

Wells other than Bored Wells
 Casing removed, Y or N? _____
 Depth to which casing was removed: _____
 Applicable, depth(s), and type of gravel/sand fill: _____
 Source of gravel or sand: _____
 Cement: From _____ to _____ From _____ to _____

Method of permanently marking location:
 Installed watertight top


Suggest setting pump @ approx. 200 ft.
you will encounter 4" well casing @ approx. 100 ft.
Suggest keeping centralizers & torque arrestors out of 4" casing

Skip Bryant
Bryant Construction
Beverly Estates # 4
Stafford
Highland Road
 Drillers Log

Depth Description of Formation or Sediment Remarks

0	10	Red Clay
10	30	Mucaceous formation / Red
30	60	Mucaceous formation / Brown
60	109	Brown Shale
109	220	Blue Shale

DIAGRAM
 (NOT TO SCALE)

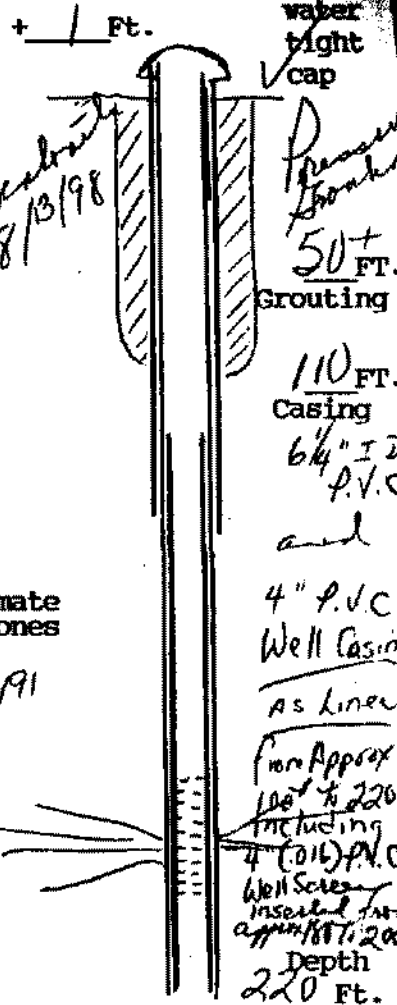

Bealville
 8/13/98

Approximate
 Water Zones

190 to 191



(User additional Sheets if necessary)

I certify that the information contained here is true and that this well was installed and constructed in accordance with the permit and further that the well complies with all applicable state and local regulations, ordinances and laws.

Name JOHN L. DANIELSON, JR., INC.
 Address 4616 HOOD DRIVE
FREDERICKSBURG, VIRGINIA 22408
 Phone (703) 898-6025 / 898-9355

Drillers Signature *John L. Danielson, Pres.*
 Date 8/13/98 Representing JOHN L. DANIELSON, JR., INC.

Virginia Contractors License Number CLASS A 2701 014084A H/H WVC