

W. Horn
Richburg, Va. 22407
8196 Fax 786-9650
804-798-2964 ODP

Commonwealth of Virginia
Uniform Water Well Completion Report

26 F-50

Owner _____
Address _____

Tax Map ID _____
VDH Permit SW-94-101
VWCB Permit _____
VWCB ID _____
County Stafford
4/6/94 Rob Sengler
T Thompson

Phone _____
Location Cannon Knolls # 50 *662 49 666
183c 46 Cannon Knolls Drive
Well Classification IIIA IIIB IIIC IV
Approx 1 1/2 Miles E of 616 & 662 * Well Data *

General Information
Drilling Method Air Rotary
Depth to Bedrock 89'
Static Water Level 30'
Well Disinfected (Y or N) _____

Date Completed 9/9/94
Yield 5 (GPM)
Stabilized Water Level 340'
Disinfectant Used _____

Total Depth of Well 380'
Length of Test approx 1 Hr.
Natural Flow (Rate) _____
Amount Used _____

Casing
From 1' To 89'
Size 6 1/4" Material P.V.C.
Weight/Schedule SDR 27

From _____ To _____
Size _____ Material _____
Weight/Schedule _____

From _____ To _____
Size _____ Material _____
Weight/Schedule _____

Gravel Pack
From _____ To _____
Hole size 10" from 0 to 60 ft.
Grout
From 0 To 60' 9"
Bore Hole Size 10"
Type Bentonite
Method Pressure Grouting

From _____ To _____
Hole size 7 1/8" from 60 to 89 ft.
From _____ To _____
Bore Hole Size _____
Type _____
Method _____

From _____ To _____
Hole size 6 1/2" from 89 to 380 ft.
From _____ To _____
Bore Hole Size _____
Type _____
Method _____

Water Zones or Screened Intervals
From 361 To 362
Mesh Size _____ Diam _____
From _____ To _____
Mesh Size _____ Diam _____

From _____ To _____
Mesh Size _____ Diam _____

* Use Data *

Private Well: Domestic Agricultural _____ Industrial _____ Monitoring _____
Public Well: Community _____ Non Community _____

* Abandonment Information *

Bored or Dug Wells
Casing Removed, Y or N? _____
If Y, Depth to which casing was removed: _____
Depth and Type of Fill: _____
Source of Fill _____
Bentonite Plugs: From _____ to _____ From _____ to _____

Wells other than Bored Wells
Casing removed, Y or N? _____
Depth to which casing was removed: _____
Applicable, depth(s), and type of gravel/sand fill: _____
Source of gravel or sand: _____
Cement: From _____ to _____ From _____ to _____

Method of permanently marking location: _____
 Installed watertight top
Suggest setting pump @ approx: 360 ft.

Ken P. New
6/14/94

941880


Johnson Classed Holes
Carroll Kroll #50
Stafford #662 off 616

Drillers Log

Depth Description of Formation or Sediment Remarks

0	10	Red Clay
10	40	Micaceous formation / Red
40	70	Micaceous formation / Brown
70	89	Brown Shale
89	380	Blue Granite

DIAGRAM (NOT TO SCALE)

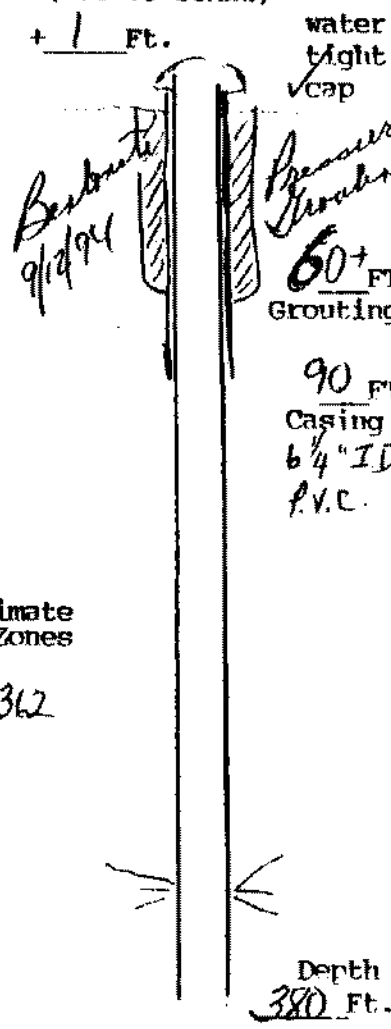

Approximate Water Zones
 361 to 362

(User additional Sheets if necessary)

I certify that the information contained here is true and that this well was installed and constructed in accordance with the permit and further that the well complies with all applicable state and local regulations, ordinances and laws.

Name JOHN L. DANIELSON, JR., INC.
 Address 4616 HOOD DRIVE
FREDERICKSBURG, VIRGINIA 22408
 Phone (703) 898-6025 / 898-9355
 Drillers Signature [Signature]
 Date 9/12/94 Representing JOHN L. DANIELSON, JR., INC.
 Virginia Contractors License Number CLASS A 2701 014084A H/H WWC