

Commonwealth of Virginia
Uniform Water Well Completion Report

Stafford
James Jones
12 Ridge Point Lane
Fredericksburg, VA 22405
371-3944 F 371-6872

Owner _____
Address _____

Tax Map ID 26F-27
VDH Permit 5W-94-120
VWCB Permit _____
VWCB ID _____

26F-27

Phone _____
Location Cannon Kells #27 off 662
183A

County Stafford
4/29/95
R. Snyder
T. T. Thompson

Well Classification IIIA _____ IIIB IIIC _____ IV _____
* Well Data *
approx 1/2 M. West of 662 & 616
and 1/2 M. North of 662

General Information
Drilling Method Air Rotary
Depth to Bedrock 65
Static Water Level 40
Well Disinfected (Y or N) _____

Date Completed 4/18/95
Yield 1 (GPM)
Stabilized Water Level 360'
Disinfectant Used _____

Total Depth of Well 400'
Length of Test approx 1 Hr.
Natural Flow (Rate) _____
Amount Used _____

Casing
From 1 to 80
Size 6 3/4" Material P.V.C.
Weight/Schedule SDR 21

From _____ To _____
Size _____ Material _____
Weight/Schedule _____

From _____ To _____
Size _____ Material _____
Weight/Schedule _____

Gravel Pack
From _____ To _____

From _____ To _____

From _____ To _____

Hole size
10" from 0 to 80 ft.

6 3/8" from 80 to 400 ft.

" from _____ to _____ ft.

Grout
From 0 To 55'
Bore Hole Size 10"
Type Bentonite
Method Pressure Grouting

From _____ To _____
Bore Hole Size _____
Type _____
Method _____

From _____ To _____
Bore Hole Size _____
Type _____
Method _____

Water Zones or Screened Intervals
From 260 To 261
Mesh Size _____ Diam _____
From _____ To _____
Mesh Size _____ Diam _____

From _____ To _____
Mesh Size _____ Diam _____

* Use Data *

Private Well: Domestic Agricultural _____ Industrial _____ Monitoring _____
Public Well: Community _____ Non Community _____

* Abandonment Information *

Bored or Dug Wells
Casing Removed, Y or N? _____
If Y, Depth to which casing was removed: _____
Depth and Type of Fill: _____
Source of Fill _____
Bentonite Plugs: From _____ to _____ From _____ to _____


Wells other than Bored Wells
Casing removed, Y or N? _____
Depth to which casing was removed: _____
Applicable, depth(s), and type of gravel/sand fill: _____
Source of gravel or sand: _____
Cement: From _____ to _____ From _____ to _____

Method of permanently marking location:
 Installed watertight top
Suggest setting pump @ approx 380 ft.

Suzanne Jones
Conroy Koelsch #27
Stafford
662 & 616

* Drillers Log *

Depth	Description of Formation or Sediment	Remarks
0	10 Red Clay	
10	65 Brown clay	
65	80 Soft Brown Rock	
80	400 Light Gray Rock	

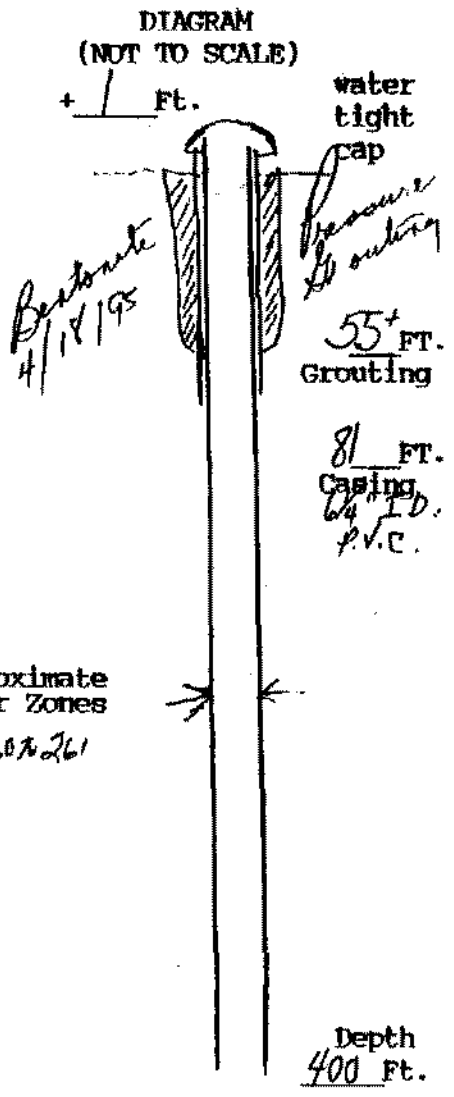

Approximate
Water Zones
260 to 261

(User additional Sheets if necessary)

I certify that the information contained here is true and that this well was installed and constructed in accordance with the permit and further that the well complies with all applicable state and local regulations, ordinances and laws.

Name JOHN L. DANIELSON, JR., INC.
Address 4616 HOOD DRIVE
FREDERICKSBURG, VIRGINIA 22408
Phone (703) 898-6025 / 898-9355
Drillers Signature [Signature]
Date 4/18/95 Representing JOHN L. DANIELSON, JR., INC.
Virginia Contractors License Number CLASS A 2701 014084A H/H WWC