

Woodbridge, Va 22192
703-490-1302

Commonwealth of Virginia
Uniform Water Well Completion Report

Owner Steve Schriener
Address 6160 School House Road
Beaeton Va. 22712
Phone 439-1345
Location Cannon Falls #14 off 662

Tax Map ID 26F-14
VDH Permit SW-94-132
VWCB Permit _____
VWCB ID _____
County Stafford
9/29/94 Ref. Gordon
3/24/94 T.F. Thompson
DJC

Well Classification IIIA _____ IIIB IIIC _____ IV _____
* Well Data *

General Information
Drilling Method Air Rotary
Depth to Bedrock 35
Static Water Level 20'
Well Disinfected (Y or N) _____

Date Completed 11/5/97
Yield 30 (GPM)
Stabilized Water Level 80'
Disinfectant Used _____

Total Depth of Well 180'
Length of Test approx 1 HR.
Natural Flow (Rate) _____
Amount Used _____

Casing
From 1 To 62
Size 4" Material P.V.C.
Weight/Schedule S.D.R. 27

From 40 To 140
Size 4" Material P.V.C.
Weight/Schedule Sch. 40

From 160 To 180
Size 4" Material P.V.C.
Weight/Schedule Sch. 40

Gravel Pack
From _____ To _____
Hole size 10" from 0 to 50ft.
Grout
From 0 To 50'
Bore Hole Size 10"
Type Bentonite
Method Pressure Grouting

From _____ To _____
Hole size 8 1/2" from 50 to 62ft.
Grout
From _____ To _____
Bore Hole Size _____
Type _____
Method _____

From _____ To _____
Hole size 6 3/8" from 62 to 180ft.
Grout
From _____ To _____
Bore Hole Size _____
Type _____
Method _____

Water Zones or Screened Intervals
From 140 To 160
Mesh Size .020 Diam 4" (P.V.C.)
From _____ To _____
Mesh Size _____ Diam _____

approx. water zone
From 110' To 111'
Mesh Size _____ Diam _____
From 150' To 151'
Mesh Size _____ Diam _____

From _____ To _____
Mesh Size _____ Diam _____
From _____ To _____
Mesh Size _____ Diam _____

* Use Data *

Private Well: Domestic Agricultural _____ Industrial _____ Monitoring _____
Public Well: Community _____ Non Community _____

* Abandonment Information *

Bored or Dug Wells
Casing Removed, Y or N? _____
If Y, Depth to which casing was removed: _____
Depth and Type of Fill: _____
Source of Fill _____
Bentonite Plugs: From _____ to _____ From _____ to _____

Wells other than Bored Wells
Casing removed, Y or N? _____
Depth to which casing was removed: _____
Applicable, depth(s), and type of gravel/sand fill: _____
Source of gravel or sand: _____
Cement: From _____ to _____ From _____ to _____


Method of permanently marking location:
 Installed watertight top
Suggest setting pump @ approx. 100 Ft.

You will encounter 4" casing @ approx 40'
Suggest keeping centralizers & torque arrestors out of 4" casing

Richard Rizzo
 Jennifer Horne
 Cannon Wells # 14 (Steve Schriener)
 Stafford
 off 662

* Drillers Log *

Depth	Description of Formation or Sediment	Remarks
0	10	Red Clay
10	35	Brown Clay
35	180	Gray Granite

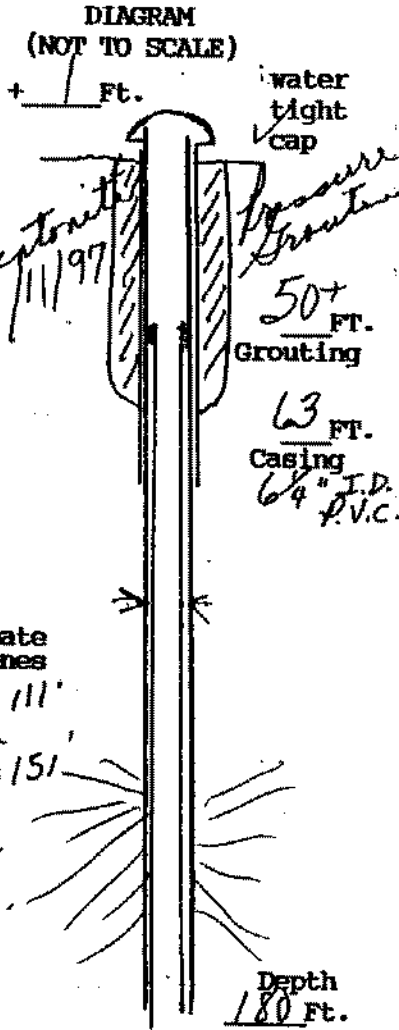

(User additional Sheets if necessary)

I certify that the information contained here is true and that this well was installed and constructed in accordance with the permit and further that the well complies with all applicable state and local regulations, ordinances and laws.

Name JOHN L. DANIELSON, JR., INC.
 Address 4616 HOOD DRIVE
FREDERICKSBURG, VIRGINIA 22408
 Phone 540 (703) 898-6025 / 898-9355
 Drillers Signature [Signature], Pres.
 Date 1/19/97 Representing JOHN L. DANIELSON, JR., INC.
 Virginia Contractors License Number CLASS A 2701 014084A H/H WWC