

COMMONWEALTH OF VIRGINIA
 WATER WELL COMPLETION REPORT
 Certification of Completion/County Permit

BWCM No. _____

26F-41

Calvert

Hamilton Street
 Alexandria, Virginia 22320

County/City STAFFORD CO.
 County/City Stamp _____

SWCB Permit _____
 County Permit _____
 Certification of inspecting official:
 This well does _____ does not _____
 meet code/low requirements.
 S. _____
 Date _____
 For Office Use

• Virginia Plane Coordinates
 _____ N
 _____ E
 • Latitude & Longitude
 _____ N
 _____ W
 • Topo. Map No. _____
 • Elevation _____
 • Formation _____
 • Lithology _____
 • River Basin _____
 • Province _____
 • Type logs _____
 • Cuttings _____
 • Water Analysis _____
 • Aquifer Test _____

• Owner Calvert Homes
 • Well Designation or Number _____
 Address _____
 Phone _____

• Drilling Contractor: Northern Virginia Drilling
 Address Route 2, Box 1084
Nokesville, VA 22123
 Phone (703) 361-6659

SW 94-193
 Tax Map I.D. No. 26F-1-41
 Subdivision CANNON KNOLLS
 Section 1
 Block _____
 Lot 41
 Class Well I _____ IIA _____
 IIB _____ IIA _____ IIB
 IIIC _____ IIID _____ IIIE _____

WELL LOCATION: _____ (feet/miles _____ direction) of _____
 and _____ feet/miles _____ (direction) of _____
 (If possible please include map showing location marked)
 Date started 9-8-94 • Date completed 9-8-94 Type rig AIR ROTARY

1. WELL DATA: New Reworked _____ Deepened _____
- Total depth 620 ft.
 - Depth to bedrock 90 ft.
 - Hole size (Also include reamed zones)
 - 10 inches from 0 to 105 1/2 ft.
 - 6 3/4 inches from 105 1/2 to 620 ft.
 - _____ inches from _____ to _____ ft.
 - Casting size (I.D.) and material
 - 6 3/4 inches from 0 to 107 ft.
 Material STEEL
 Wt. per foot 13 or wall thickness .188 in.
 - _____ inches from _____ to _____ ft.
 Material _____
 Wt. per foot _____ or wall thickness _____ in.
 - _____ inches from _____ to _____ ft.
 Material _____
 Wt. per foot _____ or wall thickness _____ in.
 - Screen size and mesh for each zone (where applicable)
 - _____ inches from _____ to _____ ft.
 - Mesh size _____ Type _____
 - _____ inches from _____ to _____ ft.
 - Mesh size _____ Type _____
 - _____ inches from _____ to _____ ft.
 - Mesh size _____ Type _____
 - _____ inches from _____ to _____ ft.
 - Mesh size _____ Type _____
 - Gravel Pack
 - From _____ to _____ ft.
 - From _____ to _____ ft.
 - Grout
 - From 0 to 100' ft., Type cement
 - From 100' to 105 1/2' ft., Type Rock cuttings

- WATER DATA • Water Temperature _____ °
- Static water level (unpumped level-measured) 90
 - Stabilized measured pumping water level _____
 - Stabilized yield 2 gpm after 1 hours
 Natural Flow: Yes _____ No flow rate: _____ gpm
 Comment on quality CLEAR

3. WATER ZONES: From 360 To 361
 From 550 To 551 From _____ To _____
 From _____ To _____ From _____ To _____

- USE DATA:
- Type of use: Drinking Livestock Watering _____
 Irrigation _____ Food processing _____ Household
 Manufacturing _____ Fire Safety _____ Cleaning _____
 Recreation _____ Aesthetic _____ Cooling or heating _____
 Injection _____ Other _____
 - Type of facility Domestic Public water supply _____
 Public institution _____ Farm _____ Industry _____
 Commercial _____ Other _____

5. PUMP DATA: Type _____ • Rated H.P. _____
 • Intake depth _____ • Capacity _____ at _____ head

6. WELLHEAD: Type well seal _____
 Pressure Tank _____ gal. Loc _____
 Sample tap _____ Measurement port _____
 Well vent _____ Pressure relief valve _____
 Gate valve _____ Check valve (when required) _____
 Electrical disconnect switch on power supply _____

7. DISINFECTION: Well disinfected _____ Yes _____ No _____
 Date _____ Disinfectant used _____
 Amount _____ Hours used _____


8. ABANDONMENT (where applicable) • Yes _____ No _____
 Casing pulled Yes _____ No _____ Not Applicable _____
 Plugging grout From _____ to _____ material _____


OVER

9. State law requires submitting to the Virginia State Water Control Board information about groundwater and wells for every well made in the state intended for water, or any other non-exempt well. This information must be submitted whether the well is completed, on standby, or abandoned. Information required includes: an accurately and completely prepared water well completion report, full data from any aquifer pumping tests, drill cuttings taken at ten foot intervals (unless exemption is secured), the results of any chemical analysis, and copies of any geophysical logs. Quarterly pumpage and use reports are required from owners of public supply and industrial wells. County or State permits to drill may be required in some parts of the state. Some counties require submission of a water well completion report. The Virginia State Health Department requires a water well completion report for public supply wells.

10. DRILLERS LOG (use additional sheets if necessary)

10. DRILLERS LOG (use additional sheets if necessary)			11.	12. DIAGRAM OF WELL CONSTRUCTION (with dimensions)
DEPTH (feet)		TYPE OF ROCK OR SOIL	REMARKS	Drilling Time (Min.)
From	To	(color, material, fossils, hardness etc.)		
0	90	over Borden		
90	620	Blue Granite		



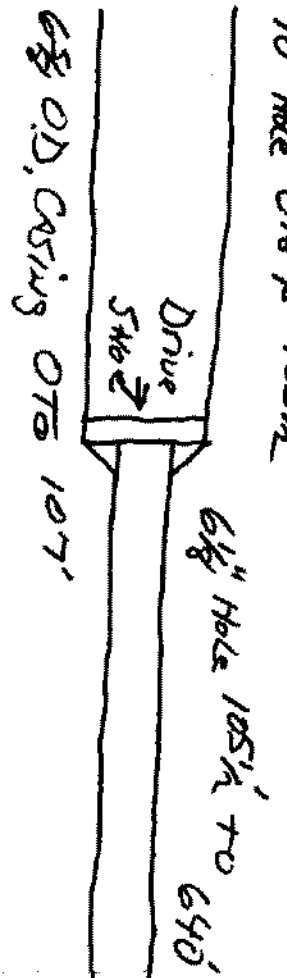

State Water Control Board Regional Offices

Valley Reg. Off.
116 North Main Street
P.O. Box 268
Bridgewater, Va. 22812
703-828-2595

Piedmont Reg. Off.
4010 West Broad Street
P.O. Box 6616
Richmond, Va. 23230
804-257-1006

Southwest Reg. Off.
408 East Main Street
P.O. Box 476
Abington, Va. 24210
703-628-5183

Tidewater Reg. Off.
287 Pembroke Office Park
Suite 310 Pembroke No. 2
Va. Beach, Va. 23462
804-499-8742

West Central Reg. Off.
Executive Park
5312 Peters creek Road
Roanoke, Va. 24019
703-982-7432

Northern Virginia Reg. Off.
5515 Cherokee Avenue
Suite 404
Alexandria, Va. 22312
703-750-9111

13. Well lot dedicated? _____ : Size _____ ft. x _____ ft. : Well house? _____
Distance to nearest pollutant source _____ ft., Type _____
Distance to nearest property line _____ ft., Building _____ ft.

14. WATER SERVICE PIPE: Checked under _____ P.S.I. for _____
minutes. Pipe size _____ inches, Material _____
Installer _____
Date _____

15. I certify that the information contained herein is true and correct and that this well and/or system has been installed and constructed in accordance with the requirements for well construction as specified in compliance with appropriate county or independent city ordinances and the laws and rules of the Commonwealth of Virginia.

Signature _____ (Seal) Date 9-8-94
(Well driller or authorized person)

License No. 015640