

Commonwealth of Virginia

Uniform Water Well Completion Report

Owner Terry Stone / For Sale
Address 13826 Mountain View Drive

Tax Map ID 26 E-38
VDH Permit SW-94-208
VWCB Permit _____
VWCB ID _____
County Stafford

Phone 972-0607
Location Cannon Knolls #38
17 -> 616 -> 662 -> Courtyards Drive

6/3/94 Ashton B. Wright
6/8/94 J.J. Thompson

Well Classification IIIA IIIB IIIC IV
• Well Data •

General Information

Drilling Method Air Rotary
Depth to Bedrock 65
Static Water Level 40'
Well Disinfected (Y or N) _____

Date Completed 9/2/94
Yield 15 (GPM)
Stabilized Water Level 180'
Disinfectant Used _____

Total Depth of Well 220'
Length of Test approx 1 Hr.
Natural Flow (Rate) _____
Amount Used _____

Casing

From 1 To 65
Size 6 1/4 Material P.V.C.
Weight/Schedule SDR 27

From _____ To _____
Size _____ Material _____
Weight/Schedule _____

From _____ To _____
Size _____ Material _____
Weight/Schedule _____

Gravel Pack

From _____ To _____

From _____ To _____

From _____ To _____

Hole size

10" from 0 to 60 ft.

7 1/8" from 60 to 15 ft.

6 1/8" from 65 to 220 ft.

Grout
From 0 To 50'
Bore Hole Size 1 1/2"
Type Bentonite
Method Pressure Grouting

From _____ To _____
Bore Hole Size _____
Type _____
Method _____

From _____ To _____
Bore Hole Size _____
Type _____
Method _____

Water Zones or Screened Intervals

From 210 To 211
Mesh Size _____ Diam _____
From _____ To _____
Mesh Size _____ Diam _____

From _____ To _____
Mesh Size _____ Diam _____

• Use Data •

Private Well: Domestic Agricultural _____ Industrial _____ Monitoring _____
Public Well: Community _____ Non Community _____

• Abandonment Information •

Bored or Dug Wells

Casing Removed, Y or N? _____
If Y, Depth to which casing was removed: _____
Depth and Type of Fill: _____
Source of Fill _____
Bentonite Plugs: From _____ to _____ From _____ to _____

Wells other than Bored Wells

Casing removed, Y or N? _____
Depth to which casing was removed: _____
Applicable, depth(s), and type of gravel/sand fill: _____
Source of gravel or sand: _____
Cement: From _____ to _____ From _____ to _____


Method of permanently marking location:

Installed watertight top
Suggest setting pump @ approx 200 ft.

Jerry Stone
TWS Builders
Carroll Knolls #38
Stafford
899 6624616

• Drillers Log •

Depth	Description of Formation or Sediment	Remarks
0	10	Red Clay
10	30	Micaceous formation / Red
30	50	Micaceous formation / Brown
50	65	Brown shale
65	220	Blue Granite

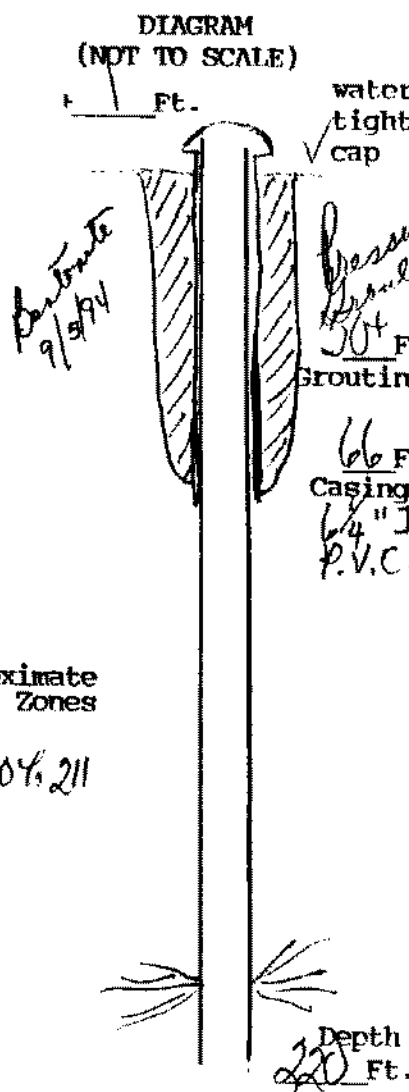

Approximate Water Zones

2104.211

(User additional Sheets if necessary)

I certify that the information contained here is true and that this well was installed and constructed in accordance with the permit and further that the well complies with all applicable state and local regulations, ordinances and laws.

Name JOHN L. DANIELSON, JR., INC.
 Address 4616 HOOD DRIVE
FREDERICKSBURG, VIRGINIA 22408
 Phone (703) 898-6025 / 898-9355

Drillers Signature [Signature]
 Date 9/6/97 representing JOHN L. DANIELSON, JR., INC.

Virginia Contractors License Number CLASS A 2701 014084A II/II WVC