

Sullivan Builders, Inc
White Oak Road
Salmonville, VA 22405
P. 373-0840 F. 373-5810 P. 310-5015

Commonwealth of Virginia
Uniform Water Well Completion Report

Owner William Stern
Address 535 Cumberland Rd
Fredericksburg, Va.
Phone 371-
Location Cannon Cross #23R *off 262*
Well Classification IIIA IIIB IIIC IV
* Well Data *

Tax Map ID 26E-23
VDH Permit SW-94-20212
VWCB Permit
VWCB ID
County Staff Ret. Sunden
T. Thompson
SIF

General Information
Drilling Method Hand Rotary
Depth to Bedrock 20'
Static Water Level Approx 40'
Well Disinfected (Y or N)

Date Completed 10/1/98
Yield 8.5 (GPM)
Stabilized Water Level 280'
Disinfectant Used

Total Depth of Well 380'
Length of Test approx 1 Hr.
Natural Flow (Rate)
Amount Used

Casing
From +1 To 60
Size 6 1/2 Material P.V.C.
Weight/Schedule S.D.R. 27

From To
Size Material
Weight/Schedule

From To
Size Material
Weight/Schedule

Gravel Pack
From To
Hole size 10" from 0 to 55ft.
Grout
From 0 To 55'
Bore Hole Size 10" *10/2/98*
Type Bentonite
Method Pressure Grouting

From To
Hole size 8 1/2" from 55 to 60ft.
Grout
From To
Bore Hole Size
Type
Method

From To
Hole size 6 1/8" from 60 to 380ft.
Grout
From To
Bore Hole Size
Type
Method

Water Zones or Screened Intervals
From 100 To 101
Mesh Size Diam
From 361 To 362
Mesh Size Diam

From To
Mesh Size Diam
From To
Mesh Size Diam

From To
Mesh Size Diam
From To
Mesh Size Diam

* Use Data *

Private Well: Domestic Agricultural Industrial Monitoring
Public Well: Community Non Community

* Abandonment Information *

Bored or Dug Wells
Casing Removed, Y or N?:
If Y, Depth to which casing was removed:
Depth and Type of Fill:
Source of Fill
Bentonite Plugs: From to From to


Wells other than Bored Wells
Casing removed, Y or N?
Depth to which casing was removed:
Applicable, depth(s), and type of gravel/sand fill:
Source of gravel or sand:
Cement: From to From to

Method of permanently marking location:
 Installed watertight top
Suggest setting pump @ approx. 300 ft.

Larry R. Sullivan Builder, Inc
Wiggins, Va
Carroll Tract # 23R
Stafford
off 662 New Carter Memorial Park
 * Drillers Log *

14-208 P.O. BOX 5707 FREDERICKSBURG, VA 22404

Depth	Description of Formation or Sediment	Remarks
0	10	Red Clay
10	20	Micaceous formation / Red
20	40	Micaceous formation / Brown
40	60	Brown Shale
60	380	Blue Granite

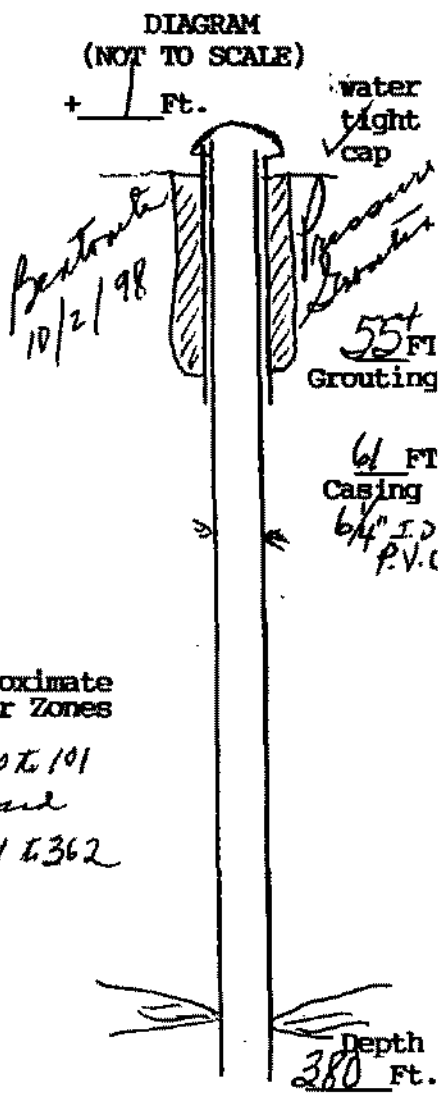

(User additional Sheets if necessary)

I certify that the information contained here is true and that this well was installed and constructed in accordance with the permit and further that the well complies with all applicable state and local regulations, ordinances and laws.

Name JOHN L. DANIELSON, JR., INC.
 Address 4616 HOOD DRIVE
FREDERICKSBURG, VIRGINIA 22408
 Phone 540 (703) 898-6025 / 898-9355
 Drillers Signature *John L. Danielson Pres*
 Date 10/2/98 Representing JOHN L. DANIELSON, JR., INC.
 Virginia Contractors License Number CLASS A 2701 014084A H/H WWC