

Fred / Chem
 Hometown Builders Inc.
 12103 Chewning Lane
 Fredericksburg, Va. 22407 Commonwealth of Virginia
 785-8333 Fax 785-8522 Uniform Water Well Completion Report

Owner Hometown Builders Construction Inc.
 Address 12103 Chewning Lane
Fredericksburg, Va. 22407
 Phone 785-8333
 Location Cannon Falls #3

Tax Map ID 26F-3
 VDH Permit _____
 VWCB Permit _____
 VWCB ID _____
 County _____

Well Classification IIIA _____ IIIB IIIC _____ IV _____
 * Well Data *

DJC

General Information
 Drilling Method Air Rotary Date Completed 11/23/94 Total Depth of Well 360'
 Depth to Bedrock 75' Yield 5 (GPM) Length of Test approx 1 Hr
 Static Water Level 40' Stabilized Water Level 320' Natural Flow (Rate) _____
 Well Disinfected (Y or N) _____ Disinfectant Used _____ Amount Used _____

Casing
 From 1' To 92' From _____ To _____
 Size 6 1/4" Material P.V.C. Size _____ Material _____
 Weight/Schedule SDR 27 Weight/Schedule _____ Weight/Schedule _____

Gravel Pack
 From _____ To _____ From _____ To _____ From _____ To _____
 Hole size 10" from 0 to 92ft. 6 1/8" from 92 to 360ft. " from _____ to _____ ft.
Grout
 From 0 To 50' From _____ To _____ From _____ To _____
 Bore Hole Size 10" Bore Hole Size _____ Bore Hole Size _____
 Type Dantanite Type _____ Type _____
 Method Tremie Casting Method _____ Method _____

Water Zones or Screened Intervals
 From 180 To 181 From _____ To _____ From _____ To _____
 Mesh Size _____ Diam _____ Mesh Size _____ Diam _____ Mesh Size _____ Diam _____
 From 340 To 341 From _____ To _____ From _____ To _____
 Mesh Size _____ Diam _____ Mesh Size _____ Diam _____ Mesh Size _____ Diam _____

* Use Data *

Private Well: Domestic Agricultural _____ Industrial _____ Monitoring _____
 Public Well: Community _____ Non Community _____

* Abandonment Information *

Bored or Dug Wells
 Casing Removed, Y or N? _____
 If Y, Depth to which casing was removed: _____
 Depth and Type of Fill: _____
 Source of Fill _____
 Bentonite Plugs: From _____ to _____ From _____ to _____

Wells other than Bored Wells
 Casing removed, Y or N? _____
 Depth to which casing was removed: _____
 Applicable, depth(s), and type of gravel/sand fill: _____
 Source of gravel or sand: _____
 Cement: From _____ to _____ From _____ to _____

1 H.P. 76PM Rev. Jacket Submersible
 Submersible Pump - 0336814
 Motor - 0396815
 WX 250 Tank


Method of permanently marking location: _____
 Installed watertight top
 Suggest setting pump @ approx. 340ft.

Fred Bely
Hometown Builders
Cannon Knolls #3
Stafford off 662417

* Drillers Log *

Depth	Description of Formation or Sediment	Remarks
0	10	Red Clay
10	75	Brown Clay
75	92	Brown Shale (soft)
92	360	Light Grey Rock

DIAGRAM
 (NOT TO SCALE)

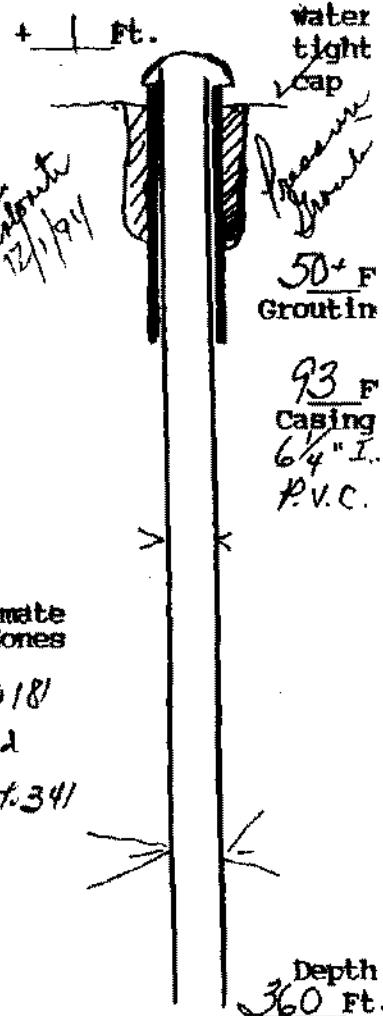

Approximate
 Water Zones

180 to 181
 and
 340 to 341

(User additional Sheets if necessary)

I certify that the information contained here is true and that this well was installed and constructed in accordance with the permit and further that the well complies with all applicable state and local regulations, ordinances and laws.

Name JOHN L. DANIELSON, JR., INC.
 Address 4616 HOOD DRIVE
FREDERICKSBURG, VIRGINIA 22408
 Phone (703) 898-6025 / 898-9355

Drillers Signature [Signature]
 Date 12/1/97 Representing JOHN L. DANIELSON, JR., INC.

Virginia Contractors License Number CLASS A 2701 014084A H/H WNC