

Ever, Va. 22508

Commonwealth of Virginia Uniform Water Well Completion Report

Owner T.W.S. Builders
 Address 13226 Mountain View Drive
SPOTSYLVANIA, Va. 22553
 Phone 972-0607
 Location Cannon Knolls # 43 #662
183C 1 mile South of intersection of 616 & 662
 Well Classification IIIA IIIB IIIC IV
 * Well Data *

Tax Map ID 26F-43
 VDH Permit SW-94230
 VWCB Permit _____
 VWCB ID _____
 County Stafford
6/28/94 Rob Sneyden
6/29/94 T Thompson

General Information
 Drilling Method 260
 Depth to Bedrock 66
 Static Water Level 30'
 Well Disinfected (Y or N) _____

Date Completed 9/1/94
 Yield 6 (GPM)
 Stabilized Water Level 20'
 Disinfectant Used _____

Total Depth of Well 260'
 Length of Test approx 1 Hr.
 Natural Flow (Rate) _____
 Amount Used _____

Casing
 From #1 To 66
 Size 4 1/2" Material P.V.C.
 Weight/Schedule SDR 27

From _____ To _____
 Size _____ Material _____
 Weight/Schedule _____

From _____ To _____
 Size _____ Material _____
 Weight/Schedule _____

Gravel Pack
 From _____ To _____
 Hole size 10" From 0 to 60 ft.
 Grout
 From 0 To 60'
 Bore Hole Size 10" 9/5/94
 Type Bentonite
 Method Pressure Grouting

From _____ To _____
 Hole size 8 1/2" From 60 to 66 ft.
 Grout
 From _____ To _____
 Bore Hole Size _____
 Type _____
 Method _____

From _____ To _____
 Hole size 6 1/8" From 66 to 260 ft.
 Grout
 From _____ To _____
 Bore Hole Size _____
 Type _____
 Method _____

Water Zones or Screened Intervals
 From 250 To 251
 Mesh Size _____ Diam _____
 From _____ To _____
 Mesh Size _____ Diam _____

From _____ To _____
 Mesh Size _____ Diam _____

* Use Data *

Private Well: Domestic Agricultural _____ Industrial _____ Monitoring _____
 Public Well: Community _____ Non Community _____

* Abandonment Information *

Bored or Dug Wells
 Casing Removed, Y or N? _____
 If Y, Depth to which casing was removed: _____
 Depth and Type of Fill: _____
 Source of Fill _____
 Bentonite Plugs: From _____ to _____ From _____ to _____

Wells other than Bored Wells
 Casing removed, Y or N? _____
 Depth to which casing was removed: _____
 Applicable, depth(s), and type of gravel/sand fill: _____
 Source of gravel or sand: _____
 Cement: From _____ to _____ From _____ to _____

Method of permanently marking location:
 Installed watertight top
 Suggest setting pump @ approx. 240 ft.


J.W.S. Builders / Jerry Stone
Cannon Wells # 43
Stafford #62
44 #616

Department of Virginia
 Environmental Health

Drillers Log

Depth Description of Formation or Sediment Remarks

0	10	Red Clay
10	30	Micaceous formation / Red
30	60	Micaceous formation / Brown
60	66	Brown Shale
66	260	Blue Granite

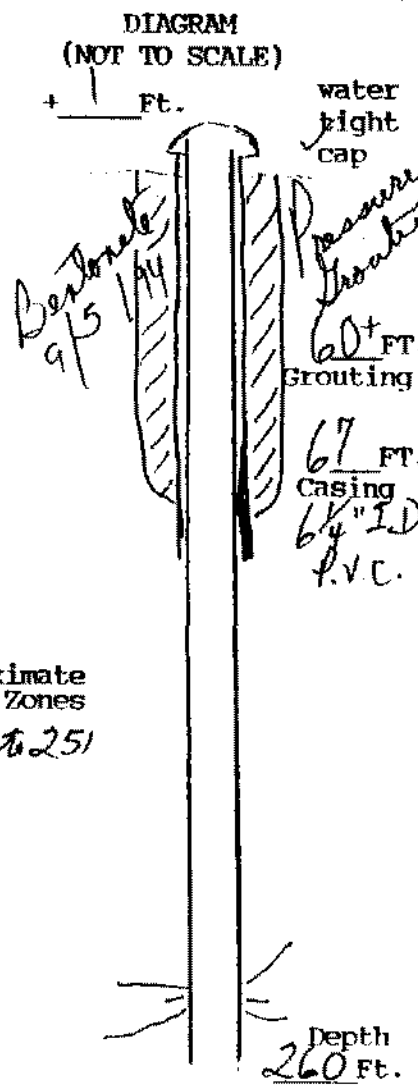

Approximate Water Zones
 250 to 251

(Use additional Sheets if necessary)

I certify that the information contained here is true and that this well was installed and constructed in accordance with the permit and further that the well complies with all applicable state and local regulations, ordinances and laws.

Name JOHN L. DANIELSON, JR., INC.
 Address 4616 HOOD DRIVE
FREDERICKSBURG, VIRGINIA 22408
 Phone (703) 898-6025 / 898-9355

Drillers Signature [Signature]
 Date 9/5/94 Representing JOHN L. DANIELSON, JR., INC.

Virginia Contractors License Number CLASS A 2701 014084A II/II WWC