


W. S. Lambert
 Cannon Knolls # 48
 Stafford
 *662 of 1*616

* Drillers Log *

Depth	Description of Formation or Sediment	Remarks
0	10	Red Clay
10	40	Micaceous formation/Red
40	80	Micaceous formation/Brown
80	89	Brown Shale
89	240	Blue Shale

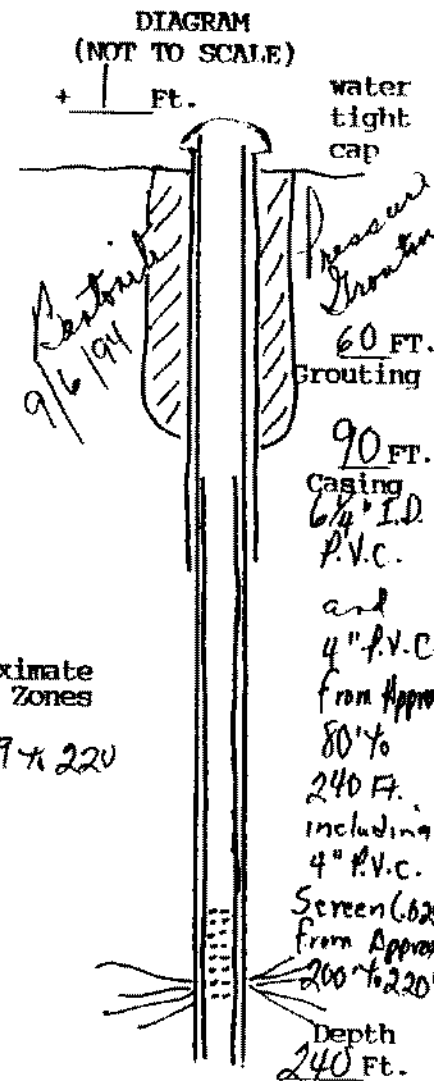

Approximate Water Zones
 219 to 220

(Use additional Sheets if necessary)

I certify that the information contained here is true and that this well was installed and constructed in accordance with the permit and further that the well complies with all applicable state and local regulations, ordinances and laws.

Name JOHN L. DANIELSON, JR., INC.
 Address 4616 HOOD DRIVE
FREDERICKSBURG, VIRGINIA 22408
 Phone (703) 898-6025 / 898-9355

Drillers Signature Chris J. Danielson, Pres.
 Date 9/6/94 Representing JOHN L. DANIELSON, JR., INC.

Virginia Contractors License Number CLASS A 2701 014084A H/H WWC