

Commonwealth of Virginia
Uniform Water Well Completion Report

Owner General Homes / For Sale
Address _____
Phone 891-1152
Location Casson Krolla # 21
183A approx 1 mile west of Inter of 616 & 662 E 3/10 M. North of 602
Well Classification IIIA IIIB IIIC IV

Tax Map ID 26F-21
VDH Permit SW-94-248
WVCB Permit _____
WVCB ID _____
County Stafford

* Well Data *

General Information

Drilling Method Air Rotary
Depth to Bedrock 45'
Static Water Level 40'
Well Disinfected (Y or N) _____

Date Completed 10/19/91
Yield 5 (GPM)
Stabilized Water Level 36.0
Disinfectant Used _____

Total Depth of Well 400
Length of Test approx 1 hr.
Natural Flow (Rate) _____
Amount Used _____

Casing

From 1 To 59
Size 6 1/4" Material P.V.C.
Weight/Schedule SDR 27

From _____ To _____
Size _____ Material _____
Weight/Schedule _____

From _____ To _____
Size _____ Material _____
Weight/Schedule _____

Gravel Pack

From _____ To _____

From _____ To _____

From _____ To _____

Hole size

10" From 1 to 59 Ft.

6 1/4" from 59 to 400 Ft.

_____ " from _____ to _____ Ft.

Grout

From 0 To 50'
Bore Hole Size 10"
Type Bentonite
Method Pressure Grouting

From _____ To _____
Bore Hole Size _____
Type _____
Method _____

From _____ To _____
Bore Hole Size _____
Type _____
Method _____

Water Zones or Screened Intervals

From 180 To 181
Mesh Size _____ Diam _____
From 370 To 371
Mesh Size _____ Diam _____

From _____ To _____
Mesh Size _____ Diam _____
From _____ To _____
Mesh Size _____ Diam _____

From _____ To _____
Mesh Size _____ Diam _____
From _____ To _____
Mesh Size _____ Diam _____

* Use Data *

Private Well: Domestic Agricultural _____ Industrial _____ Monitoring _____
Public Well: Community _____ Non Community _____

* Abandonment Information *

Bored or Dug Wells

Casing Removed, Y or N? _____
If Y, Depth to which casing was removed: _____
Depth and Type of Fill: _____
Source of Fill _____
Bentonite Plugs: From _____ to _____ From _____ to _____

Wells other than Bored Wells

Casing removed, Y or N? _____
Depth to which casing was removed: _____
Applicable, depth(s), and type of gravel/sand fill: _____
Source of gravel or sand: _____
Cement: From _____ to _____ From _____ to _____

Method of permanently marking location:

Installed watertight top
Suggest setting pump @ approx. 380 ft.

Martin Rust

Emerald Homes


Cannon Knolls # 21

Stafford # 662

• Drillers Log •

Depth	Description of Formation or Sediment	Remarks
0	10 Red Clay	
10	45 Brown Clay	
45	59 Soft Brown Shale	
59	400 Light Grey Rock	

DIAGRAM (NOT TO SCALE)

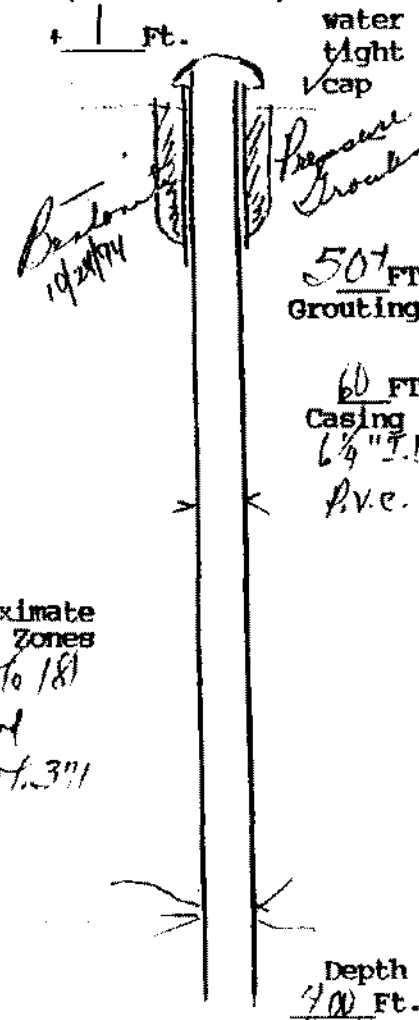

Approximate Water Zones
180 to 181
and
370 to 371

(Use additional Sheets if necessary)

I certify that the information contained here is true and that this well was installed and constructed in accordance with the permit and further that the well complies with all applicable state and local regulations, ordinances and laws.

Name JOHN L. DANIELSON, JR., INC.
 Address 4616 HOOD DRIVE
FREDERICKSBURG, VIRGINIA 22408
 Phone (703) 898-6025 / 898-9355

Drillers Signature John L. Danielson, Pres
 Date 10/24/94 Representing JOHN L. DANIELSON, JR., INC.

Virginia Contractors License Number CLASS A 2701 014084A H/H WWC

