

**COMMONWEALTH OF VIRGINIA
WATER WELL COMPLETION REPORT**

* BWCM No. _____

(Certification of Completion/County Permit)

State Water Control Board
P. O. Box 11143
2111 North Hamilton St.
Richmond, Va. 23230

County/City STAFFORD

County/City Stamp

• Virginia Plane Coordinates
_____ N
_____ E
Latitude & Longitude
_____ N
_____ W

• Topo. Map No. _____
• Elevation _____ ft.
• Formation _____
• Lithology _____
• River Basin _____
• Province _____
• Type Logs _____
• Cuttings _____
• Water Analysis _____
• Aquifer Test _____

• Owner SUNSHINE HOME BUILDERS
• Well Designation or Number SWP-00-191
Address P.O. BOX 840 FARRISVILLE VA
Phone 659-1113

• Drilling Contractor CURTIS BROS. DRILLING & PUMP SERVICE LLC
Address 5069 SUMERDUCK RD.
SUMERDUCK, VA 22742
Phone 540-439-8377

SWCB Permit _____
County Permit _____

Certification of inspecting official:
This well does _____ does not
meet code/low requirements.
S. _____
Date _____

For Office Use

Tax Map I.D. No. 26J-5
Subdivision STONY HILL ETT
Section 1
Block _____
Lot 5
Class Well: I _____ II A _____
II B _____ III A _____ III B
III C _____ III D _____ III E _____

WELL LOCATION: _____ (feet/miles _____ direction) of
and _____ (feet/miles _____ direction) of
(If possible please include map showing location marked)

Date started 11/29/00 • Date completed 11/29/00 Type rig AIR

I. WELL DATA: New Reworked _____ Deepened _____

• Total depth 185 ft.
• Depth to bedrock 90 ft.

• Hole size (Also include reamed zones)
• 10 inches from 0 to 100 ft.
• 6 inches from 100 to 185 ft.
• _____ inches from _____ to _____ ft.

• Casing size (I.D.) and material
• 64 inches from 0 to 100 ft.
Material PLASTIC
Wt. per foot 4 or wall thickness 244 in.
• _____ inches from _____ to _____ ft.
Material _____
Wt. per foot _____ or wall thickness _____ in.
• _____ inches from _____ to _____ ft.
Material _____
Wt. per foot _____ or wall thickness _____ in.

• Screen size and mesh for each zone (where applicable)
• _____ inches from _____ to _____ ft.
• Mesh size _____ Type _____
• _____ inches from _____ to _____ ft.
• Mesh size _____ Type _____
• Gravel pack
• From _____ to _____ ft.
• From _____ to _____ ft.

• Grout
• From 0 to 50+ ft., Type PRESSURE
• From _____ to _____ ft., Type _____

2. WATER DATA • Water temperature _____ OF
• Static water level (unpumped level-measured) 20 ft.
• Stabilized measured pumping water level 184 ft.
• Stabilized yield 10 gpm after 1 hours
Natural Flow: Yes _____ No _____ flow rate _____ gpm
Comment on quality _____

3. WATER ZONES: From _____ To _____
From _____ To _____ From _____ To _____
From _____ To _____ From _____ To _____

4. USE DATA:
Type of use: Drinking Livestock Watering _____
Irrigation _____ Food processing _____ Household
Manufacturing _____ Fire safety _____ Cleaning _____
Recreation _____ Aesthetic _____ Cooling or heating _____
Injection _____ Other _____

• Type of facility: Domestic Public water supply _____
Public institution _____ Farm _____ Industry _____
Commercial _____ Other _____

5. PUMP DATA: Type _____ • Rated H.P. _____
• Intake depth _____ • Capacity _____ at _____ head

6. WELLHEAD: Type well seal _____
Pressure tank _____ gal. Loc. _____
Sample tap _____ Measurement port _____
Well vent _____ Pressure relief valve _____
Gate valve _____ Check valve (when required) _____
Electrical disconnect switch on power supply _____

7. DISINFECTION: Well disinfected yes _____ no _____
Date _____ Disinfectant used _____
Amount _____ Hours used _____

8. ABANDONMENT (where applicable) • yes _____ no _____
Casing pulled yes _____ no _____ not applicable _____
Plugging grout From _____ to _____ material _____

9. State law requires submitting to the Virginia State Water Control Board information about groundwater and wells for every well made in the State intended for water, or any other non-exempt well. This information must be submitted whether the well is completed, on standby, or abandoned. Information required includes: an accurately and completely prepared water well completion report, full data from any aquifer pumping tests, drill cuttings taken at ten foot intervals (unless exemption is secured), the results of any chemical analyses, and copies of any geophysical logs. Quarterly pumpage and use reports are required from owners of public supply and industrial wells. County or State permits to drill may be required in some parts of the state. Some counties require submission of a water well completion report. The Virginia State Health Department requires a water well completion report for public supply wells.


10. DRILLERS LOG (use additional Sheets if necessary)

DEPTH (feet)		TYPE OF ROCK OR SOIL (color, material, fossils, hardness, etc.)	REMARKS (water, casing, cavities, broken, core, shot, etc.)
From	To		
0	90	BROWN SOIL	
90	185	BLUE STONE	

11. Drilling Time (Min.)

12. DIAGRAM OF WELL CONSTRUCTION (with dimensions)

Well 185 FT
Casing 100 FT
Grout 50 FT
Water Tight Cap

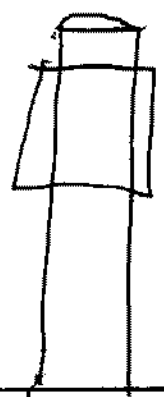

13. Well lot dedicated? _____ Size _____ ft. X _____ ft.; Well house? _____
Distance to nearest pollutant source _____ ft., Type _____
Distance to nearest property line _____ ft., Building _____ ft.

14. WATER SERVICE PIPE: Checked under _____ p. s. i. for _____
minutes. Pipe size _____ inches, Material _____
Installer _____
Date _____

15. I certify that the information contained herein is true and correct and that this well and/or system has been installed and constructed in accordance with the requirements for well construction as specified in compliance with appropriate county or independent city ordinances and the laws and rules of the Commonwealth of Virginia.

State Water Control Board Regional Offices

Valley Reg. Off.
116 North Main Street
P. O. Box 268
Bridgewater, Va. 22612
703-628-2595

Piedmont Reg. Off.
4010 West Broad Street
P. O. Box 6616
Richmond, Va. 23230
804-257-1006

Southwest Reg. Off.
408 East Main Street
P. O. Box 476
Abingdon, Va. 24210
703-628-3183

Tidewater Reg. Off.
287 Pomeroy Office Park
Suite 310 Pembroke No. 2
Va. Beach, Va. 23462
804-499-8742

West Central Reg. Off.
Executive Park
3312 Peters Creek Road
Roanoke, Va. 24019
703-982-7452

Northern Virginia Reg. Off.
5515 Cherokee Avenue
Suite 404
Alexandria, Va. 22312
703-750-9111

Signature Jerry Curt (Seal) Date 11/29/00
(Well driller or authorized person)
License No. 024220A