

Johnson  
 Johnson  
 Fibers, VA 22405  
 (540) 372-3098

Commonwealth of Virginia  
 Uniform Water Well Completion Report



Owner: Battlefield Homes (builder)  
 Address: 11932 Cherry Rd.  
Fredericksburg, VA 22409  
 Phone: 786-2388  
 Location: 301 Stony Hill Rd.

Tax Map ID: 26-29 D  
 VOH Permit: SWP-01-130  
 VWCB Permit: \_\_\_\_\_  
 VWCB ID: \_\_\_\_\_  
 County: Stafford

Well Classification: IIIA \_\_\_\_\_ IIIB  IIIC \_\_\_\_\_ IV \_\_\_\_\_  
 'Well Data'

General Information  
 Drilling Method: Air Rotary  
 Depth to Bedrock: 83'  
 Static Water Level: 35'  
 Disinfectant (Y or N): N

Date Completed: 8/29/01  
 Yield: 10 (GPM)  
 Stabilized Water Level: \_\_\_\_\_  
 Disinfectant Used: \_\_\_\_\_

Total Depth of Well: 360'  
 Length of Test: 1 hr.  
 Natural Flow (Rate): N  
 Amount Used: \_\_\_\_\_

Casing From: +1 1/2' To: 133 1/2'  
 Size: 6 1/4" ID Material: PVC  
 Weight/Schedule: 3.491 # per ft.  
.250 wall

From \_\_\_\_\_ To \_\_\_\_\_  
 Size \_\_\_\_\_ Material \_\_\_\_\_  
 Weight/Schedule \_\_\_\_\_

From \_\_\_\_\_ To \_\_\_\_\_  
 Size \_\_\_\_\_ Material \_\_\_\_\_  
 Weight/Schedule \_\_\_\_\_

Casing Pipe From \_\_\_\_\_ To \_\_\_\_\_  
 Hole Size \_\_\_\_\_

From \_\_\_\_\_ To \_\_\_\_\_  
 " from \_\_\_\_\_ to \_\_\_\_\_ ft.

From \_\_\_\_\_ To \_\_\_\_\_  
 " from \_\_\_\_\_ to \_\_\_\_\_ ft.

From: 90' To: 0  
 Bore Hole Size: 10" x 133 1/2'  
 Type: Bentonite E-2 seal  
 Method: pressure grout from bottom to top

From: 133 1/2' To: 90'  
 Bore Hole Size: 10" x 133 1/2'  
 Type: backfill & natural  
 Method: CAUSE-IN

From \_\_\_\_\_ To \_\_\_\_\_  
 Bore Hole Size \_\_\_\_\_  
 Type \_\_\_\_\_  
 Method \_\_\_\_\_

Water Zones or Screened Intervals  
 From: 170' To: 172'  
 Mesh Size \_\_\_\_\_ Diam \_\_\_\_\_  
 From \_\_\_\_\_ To \_\_\_\_\_  
 Mesh Size \_\_\_\_\_ Diam \_\_\_\_\_

From: 349' To: 351'  
 Mesh Size \_\_\_\_\_ Diam \_\_\_\_\_  
 From \_\_\_\_\_ To \_\_\_\_\_  
 Mesh Size \_\_\_\_\_ Diam \_\_\_\_\_

From \_\_\_\_\_ To \_\_\_\_\_  
 Mesh Size \_\_\_\_\_ Diam \_\_\_\_\_  
 From \_\_\_\_\_ To \_\_\_\_\_  
 Mesh Size \_\_\_\_\_ Diam \_\_\_\_\_

' Use Data '

Purpose Well: Domestic  Agricultural \_\_\_\_\_ Industrial \_\_\_\_\_ Monitoring \_\_\_\_\_  
 Public Well: Community \_\_\_\_\_ Non Community \_\_\_\_\_


' Abandonment Information '

Screen of Old Wells  
 Casing Removed Y or N? \_\_\_\_\_  
 Depth to which casing was removed: \_\_\_\_\_  
 Depth and Type of Fill: \_\_\_\_\_  
 Source of \_\_\_\_\_  
 Reference Dates: From \_\_\_\_\_ to \_\_\_\_\_ From \_\_\_\_\_ to \_\_\_\_\_

Wells other than Bored Wells  
 Casing removed, Y or N? \_\_\_\_\_  
 Depth to which casing was removed: \_\_\_\_\_  
 Applicable, depth(s), and type of gravel/sand fill: \_\_\_\_\_  
 Source of gravel or sand: \_\_\_\_\_  
 Cement: From \_\_\_\_\_ to \_\_\_\_\_ From \_\_\_\_\_ to \_\_\_\_\_

Has top of permanently marking location \_\_\_\_\_  
 Installed watertight top

0	10'	Orange sandy clay
10'	83'	brown sandy clay
83'	123'	brown soft broken-up rock
123'	133'	brown med. hard rock
133'	360'	grey hard rock

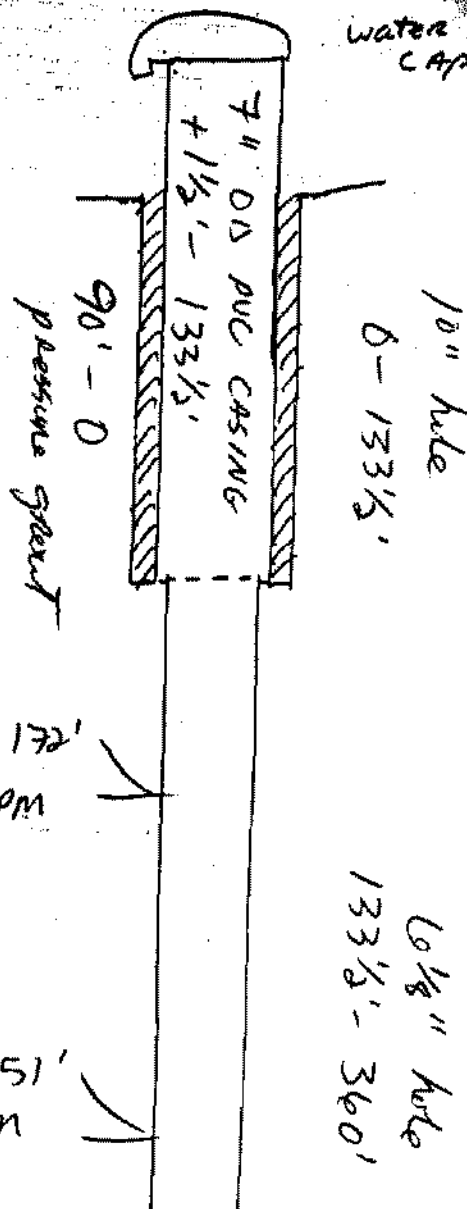

170'-172'  
3 GPM

349'-351'  
7 GPM

(Use additional Sheets if necessary)

The information contained here is true and that this well was installed and constructed in accordance with the permit and the well complies with all applicable state and local regulations, ordinances and laws.

ARTESIAN WATER WELLS, INC.

11412 GORDON RD

F. BURG VA 22407

(540) 785-8163

Wade A. Driffling

8/29/01 Representing A. W. W. S. O.

Professional License Number 2705-046112