

Henderson  
P.O. Box 1622 - College Station  
Fredericksburg, Va. 22402  
898-0029

Commonwealth of Virginia  
Uniform Water Well Completion Report

Owner James C. Henderson Construction Inc / For Sale  
Address P.O. Box 1622 - College Station  
Fredericksburg, Va.  
Phone 898-0029  
Location Canon Kasele #2

Tax Map ID 26F-2  
VDH Permit SWP-94-462  
VWCB Permit \_\_\_\_\_  
VWCB ID \_\_\_\_\_  
County Stafford  
12/2/94 Pat Sugden

Well Classification IIIA IIIB  IIIC IV  
\* Well Data \*

General Information

Drilling Method Air Rotary  
Depth to Bedrock 75'  
Static Water Level 40'  
Well Disinfected (Y or N) \_\_\_\_\_

Date Completed 3/17/95  
Yield 4 (GPM)  
Stabilized Water Level 280'  
Disinfectant Used \_\_\_\_\_

Total Depth of Well 320'  
Length of Test approx 1 Hr.  
Natural Flow (Rate) \_\_\_\_\_  
Amount Used \_\_\_\_\_

Casing

From +1 To 89  
Size 6 3/4" Material PVC  
Weight/Schedule SDR 27

From 89 To 109  
Size 6 3/4" Material PVC  
Weight/Schedule SDR 27

From \_\_\_\_\_ To \_\_\_\_\_  
Size \_\_\_\_\_ Material \_\_\_\_\_  
Weight/Schedule \_\_\_\_\_

Gravel Pack

From \_\_\_\_\_ To \_\_\_\_\_

From \_\_\_\_\_ To \_\_\_\_\_

From \_\_\_\_\_ To \_\_\_\_\_

Hole size

10" from 0 to 70 ft.

7 7/8" from 70 to 320 ft.

\_\_\_\_\_ " from \_\_\_\_\_ to \_\_\_\_\_ ft.

Grout

From 0 To 60

From \_\_\_\_\_ To \_\_\_\_\_

From \_\_\_\_\_ To \_\_\_\_\_

Bore Hole Size 10"

Bore Hole Size \_\_\_\_\_

Bore Hole Size \_\_\_\_\_

Type Bentonite

Type \_\_\_\_\_

Type \_\_\_\_\_

Method Pressure Grouting

Method \_\_\_\_\_

Method \_\_\_\_\_

Water Zones or Screened Intervals

From 180 To 181

From \_\_\_\_\_ To \_\_\_\_\_

From \_\_\_\_\_ To \_\_\_\_\_

Mesh Size \_\_\_\_\_ Diam \_\_\_\_\_

Mesh Size \_\_\_\_\_ Diam \_\_\_\_\_

Mesh Size \_\_\_\_\_ Diam \_\_\_\_\_

From 290 To 291

From \_\_\_\_\_ To \_\_\_\_\_

From \_\_\_\_\_ To \_\_\_\_\_

Mesh Size \_\_\_\_\_ Diam \_\_\_\_\_

Mesh Size \_\_\_\_\_ Diam \_\_\_\_\_

Mesh Size \_\_\_\_\_ Diam \_\_\_\_\_

\* Use Data \*

Private Well: Domestic  Agricultural \_\_\_\_\_ Industrial \_\_\_\_\_ Monitoring \_\_\_\_\_  
Public Well: Community \_\_\_\_\_ Non Community \_\_\_\_\_

\* Abandonment Information \*

Bored or Dug Wells

Casing Removed, Y or N? \_\_\_\_\_  
If Y, Depth to which casing was removed: \_\_\_\_\_  
Depth and Type of Fill: \_\_\_\_\_  
Source of Fill \_\_\_\_\_  
Bentonite Plugs: From \_\_\_\_\_ to \_\_\_\_\_ From \_\_\_\_\_ to \_\_\_\_\_

Wells other than Bored Wells

Casing removed, Y or N? \_\_\_\_\_  
Depth to which casing was removed: \_\_\_\_\_  
Applicable, depth(s), and type of gravel/sand fill: \_\_\_\_\_  
Source of gravel or sand: \_\_\_\_\_  
Cement: From \_\_\_\_\_ to \_\_\_\_\_ From \_\_\_\_\_ to \_\_\_\_\_

Method of permanently marking location: \_\_\_\_\_

Installed watertight top  
Suggest setting pump @ approx 300 ft.


944141  
6644

James Henderson  
Cannon Wells #2  
Stafford  
 Off 662-616 477

' Drillers Log '

Depth Description of Formation or Sediment Remarks

0	10	Red Clay
10	75	Brown Clay
75	109	Soft Brown Rock
109	320	Light Grey Rock

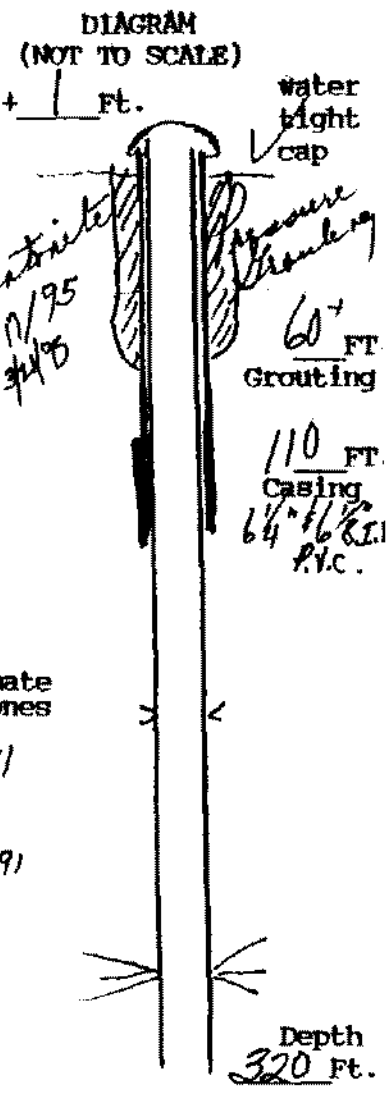

Approximate Water Zones  
 180 to 181  
 and  
 290 to 291



(User additional Sheets if necessary)

I certify that the information contained here is true and that this well was installed and constructed in accordance with the permit and further that the well complies with all applicable state and local regulations, ordinances and laws.

Name JOHN L. DANIELSON, JR., INC.  
 Address 4616 HOOD DRIVE  
FREDERICKSBURG, VIRGINIA 22408  
 Phone (703) 898-6025 / 898-9355

Drillers Signature John L. Danielson, Pres.  
 Date 3/21/95 Representing JOHN L. DANIELSON, JR., INC.

Virginia Contractors License Number CLASS A 2701 014084A H/H WMC