

Donigian Clean Homes
4521 Clark Road
Fredericksburg, Va. 22407 Commonwealth of Virginia
785-8196 / 785-7347 Uniform Water Well Completion Report
McDermott

Owner Donigian Clean Homes / For Sale Tax Map ID 26F-1
 Address 4521 Clark Road VDH Permit SWP-94-474
Fredericksburg, Va. 22407 VWCB Permit _____
 Phone 785-8196 VWCB ID _____
 Location Canon Krolla #11 (602) near Lakeside County STAFFORD
183A 12/14/94 Robinson
 Well Classification IIIA _____ IIIB IIIC _____ IV _____
 * Well Data * SFF

General Information
 Drilling Method air rotary Date Completed 7/31/95 Total Depth of Well 180
 Depth to Bedrock 107 Yield 20 (GPM) Length of Test approx. 1 Hr.
 Static Water Level 40 GPM Stabilized Water Level approx 80 Natural Flow (Rate) _____
 Well Disinfected (Y or N) _____ Disinfectant Used _____ Amount Used _____

Casing From <u>+1</u> To <u>87</u>	From <u>87</u> To <u>107</u>	From <u>100</u> To <u>140</u>
Size <u>6 3/4"</u> Material <u>P.V.C.</u>	Size <u>6 3/4"</u> Material <u>P.V.C.</u>	Size <u>4"</u> Material <u>P.V.C.</u>
Weight/Schedule <u>SDR 27</u>	Weight/Schedule <u>SDR 21</u>	Weight/Schedule <u>Sch 40</u>

Gravel Pack From _____ To _____	From _____ To _____	From _____ To _____
Hole size <u>10"</u> from <u>0</u> to <u>60ft.</u>	<u>7 7/8"</u> from <u>60</u> to <u>107ft.</u>	<u>6 1/2"</u> from <u>107</u> to <u>180ft.</u>
Grout From <u>0</u> To <u>50' 8/2</u>	From _____ To _____	From _____ To _____
Bore Hole Size <u>10"</u>	Bore Hole Size _____	Bore Hole Size _____
Type <u>Bentonite</u>	Type _____	Type _____
Method <u>Pressure Grouting</u>	Method _____	Method _____

Water Zones or Screened Intervals	<u>approx water zone</u>	
From <u>140</u> To <u>160</u>	From <u>150</u> To <u>151</u>	From _____ To _____
Mesh Size <u>20</u> Diam <u>4" (P.V.C.)</u>	Mesh Size _____ Diam _____	Mesh Size _____ Diam _____
From _____ To _____	From _____ To _____	From _____ To _____
Mesh Size _____ Diam _____	Mesh Size _____ Diam _____	Mesh Size _____ Diam _____

* Use Data *

Private Well: Domestic Agricultural _____ Industrial _____ Monitoring _____
 Public Well: Community _____ Non Community _____

* Abandonment Information *

Bored or Dug Wells	Wells other than Bored Wells
Casing Removed, Y or N? _____	Casing removed, Y or N? _____
If Y, Depth to which casing was removed: _____	Depth to which casing was removed _____
Depth and Type of Fill: _____	Applicable, depth(s), and type of gravel/sand fill: _____
Source of Fill _____	Source of gravel or sand: _____
Bentonite Plugs: From _____ to _____ From _____ to _____	Cement: From _____ to _____ From _____ to _____

Method of permanently marking location: _____
 Installed watertight top
 Suggest setting pump @ approx. 100 ft.
you will encounter 4" casing @ approx 100'
suggest keeping centralizers & torque wrenches out of 4" casing


For Sale McDeemott

STARTED 6/2/62

- Near Curtis Memorial Park -
* Drillers Log *

Depth	Description of Formation or Sediment	Remarks
0 10	Red Clay	
10 40	Micaceous Formation / Red	
40 70	Micaceous Formation / Brown	
70 107	Brown Shale	
107 180	Blue Shale	

DIAGRAM
(NOT TO SCALE)

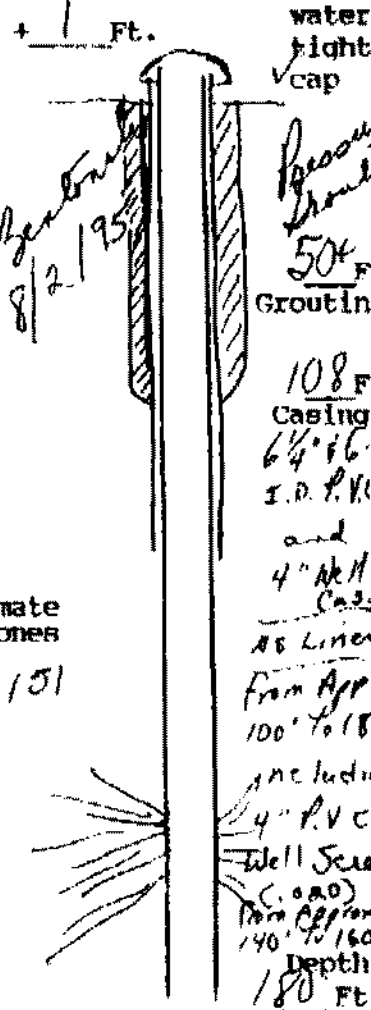

Approximate
Water Zones
150 to 151

(Use additional Sheets if necessary)

I certify that the information contained here is true and that this well was installed and constructed in accordance with the permit and further that the well complies with all applicable state and local regulations, ordinances and laws.

Name JOHN L. DANIELSON, JR., INC.
Address 4616 HOOD DRIVE
FREDERICKSBURG, VIRGINIA 22408
Phone (703) 898-6025 / 898-9355

Drillers Signature John L. Danielson, Jr.
Date 6/2/75 Representing JOHN L. DANIELSON, JR., INC.

Virginia Contractors License Number CLASS A 2701 014084A H/IT WVC