

**Commonwealth of Virginia
Uniform Water Well Completion Report**

703-491-5403 / 609-5299 F 491-8470

Owner William & Sandra Lambert
 Address 3010 Pearcy Lane
Woodbridge, Va 22192
 Phone 1-703-491-5403
 Location 183A Carson Knolls #7
 Well Classification IIIA IIIB IIIC IV

Tax Map ID 26F-7
 VDH Permit SWP-95-114
 VWCB Permit _____
 VWCB ID _____
 County 4/24/95 Rob Smydan
SFF

* Well Data *

General Information
 Drilling Method Air Rotary
 Date Completed 7/12/95
 Depth to Bedrock 67
 Yield 25 (GPM)
 Static Water Level 30'
 Stabilized Water Level 100'
 Well Disinfected (Y or N) _____
 Disinfectant Used _____

Total Depth of Well 160'
 Length of Test approx 1 Hr
 Natural Flow (Rate) _____
 Amount Used _____

Casing
 From +1 To 67
 Size 6 3/4" Material P.V.C.
 Weight/Schedule SDR 27
 From 60 To 120
 Size 4" Material P.V.C.
 Weight/Schedule Sch 40

From 140 To 160
 Size 4" Material P.V.C.
 Weight/Schedule Sch 40

Gravel Pack
 From _____ To _____
 Hole size 10" from 0 to 60 ft.
 Grout 7 7/8" from 60 to 67 ft.
 From _____ To _____
 Bore Hole Size _____
 Type Bentonite
 Method Pressure Grouting

Water Zones or Screened Intervals
 From 120 To 140
 Mesh Size 20 Diam 4" (P.V.C.)
 From _____ To _____
 Mesh Size _____ Diam _____

* Use Data *

Private Well: Domestic Agricultural _____ Industrial _____ Monitoring _____
 Public Well: Community _____ Non Community _____

*** Abandonment Information ***

Bored or Dug Wells
 Casing Removed, Y or N?: _____
 If Y, Depth to which casing was removed: _____
 Depth and Type of Fill: _____
 Source of Fill: _____
 Bentonite Plugs: From _____ to _____ From _____ to _____

Wells other than Bored Wells
 Casing removed, Y or N? _____
 Depth to which casing was removed: _____
 Applicable, depth(s), and type of gravel/sand fill: _____
 Source of gravel or sand: _____
 Cement: From _____ to _____ From _____ to _____


Method of permanently marking location: Installed watertight top
 Suggest setting pump @ approx 120 ft.
You will encounter 4" casing @ approx 60'
Suggest keeping torque arrestors & centralizers out of 4" casing

William & Sandra Lambert
Carson Wells # 7
Stafford
 662

* Drillers Log *

Depth Description of Formation or Sediment Remarks

0	10	Red Clay	
10	40	Micaceous formation / Red	
40	60	Micaceous formation / Brown	
60	67	Brown Shale	set 4" P.V.C Well Casing + Screen due to softness of formation
67	160	Blue Shale	

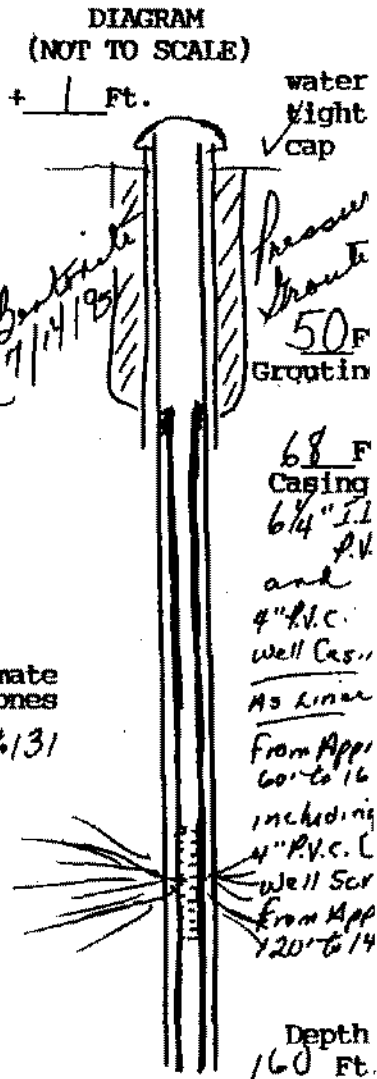

Approximate Water Zones
 130 to 131

(User additional Sheets if necessary)

I certify that the information contained here is true and that this well was installed and constructed in accordance with the permit and further that the well complies with all applicable state and local regulations, ordinances and laws.

Name JOHN L. DANIELSON, JR., INC.
 Address 4616 HOOD DRIVE
FREDERICKSBURG, VIRGINIA 22408
 Phone (703) 898-6025 / 898-9355

Drillers Signature John L. Danielson, Pres.
 Date 7/17/95 Representing JOHN L. DANIELSON, JR., INC.

Virginia Contractors License Number CLASS A 2701 014084A H/H WVC