

COMMONWEALTH OF VIRGINIA  
 WATER WELL COMPLETION REPORT  
 Certification of Completion/County Permit

• BWCM No. \_\_\_\_\_

266-7

Board  
 Hamilton Street  
 Wood, Virginia 23230

County/City: STAFFORD  
 County/City Stamp \_\_\_\_\_

SWCB Permit \_\_\_\_\_  
 County Permit \_\_\_\_\_  
 Certification of inspecting official:  
 This well does \_\_\_\_\_ does not \_\_\_\_\_  
 meet code/low requirements.  
 S. \_\_\_\_\_  
 Date \_\_\_\_\_  
 For Office Use

• Virginia Plane Coordinates  
 \_\_\_\_\_ N  
 \_\_\_\_\_ E  
 • Latitude & Longitude  
 \_\_\_\_\_ N  
 \_\_\_\_\_ W  
 • Topo. Map No. \_\_\_\_\_  
 • Elevation \_\_\_\_\_  
 • Formation \_\_\_\_\_  
 • Lithology \_\_\_\_\_  
 • River Basin \_\_\_\_\_  
 • Province \_\_\_\_\_  
 • Type logs \_\_\_\_\_  
 • Cuttings \_\_\_\_\_  
 • Water Analysis \_\_\_\_\_  
 • Aquifer Test \_\_\_\_\_

• Owner Linda Belles  
 • Well Designation or Number \_\_\_\_\_  
 Address \_\_\_\_\_  
 Phone (540) 441-1363  
 • Drilling Contractor: Northern Virginia Drilling  
 Address 7256 Foster Lane  
Nokeville, VA 22123  
 Phone: (703) 361-6859

SWP-96-168  
 Tax Map I.D. No. 266-7  
 Subdivision Granite Ests  
 Section \_\_\_\_\_  
 Block \_\_\_\_\_  
 Lot # 7  
 Class Well I \_\_\_\_\_ II A \_\_\_\_\_  
 IIB \_\_\_\_\_ IIIA \_\_\_\_\_ IIIB   
 IIIC \_\_\_\_\_ IIID \_\_\_\_\_ IIIE \_\_\_\_\_

WELL LOCATION: \_\_\_\_\_ (feet/miles \_\_\_\_\_ direction) of \_\_\_\_\_  
 and \_\_\_\_\_ feet/miles \_\_\_\_\_ (direction) of \_\_\_\_\_  
 (If possible please include map showing location marked)  
 Date started 10-21-96 • Date completed 10-22-96 Type rig Air/Rotary

1. WELL DATA: New  Reworked \_\_\_\_\_ Deepened \_\_\_\_\_  
 • Total depth 240 ft.  
 • Depth to bedrock 124 ft.  
 • Hole size (Also include reamed zones)  
 • 10 inches from 0 to 12 1/2 ft.  
 • 6 1/8 inches from 124 to 240 ft.  
 • \_\_\_\_\_ inches from \_\_\_\_\_ to \_\_\_\_\_ ft.  
 • Casing size (I.D.) and material  
 • 6 1/8 inches from 0 to 124 ft.  
 Material Steel  
 Wt. per foot 13 lbs or wall thickness .288 in.  
 • \_\_\_\_\_ inches from \_\_\_\_\_ to \_\_\_\_\_ ft.  
 Material \_\_\_\_\_  
 Wt. per foot \_\_\_\_\_ or wall thickness \_\_\_\_\_ in.  
 • \_\_\_\_\_ inches from \_\_\_\_\_ to \_\_\_\_\_ ft.  
 Material \_\_\_\_\_  
 Wt. per foot \_\_\_\_\_ or wall thickness \_\_\_\_\_ in.  
 • Screen size and mesh for each zone (where applicable)  
 • \_\_\_\_\_ inches from \_\_\_\_\_ to \_\_\_\_\_ ft.  
 • Mesh size \_\_\_\_\_ Type \_\_\_\_\_  
 • \_\_\_\_\_ inches from \_\_\_\_\_ to \_\_\_\_\_ ft.  
 • Mesh size \_\_\_\_\_ Type \_\_\_\_\_  
 • \_\_\_\_\_ inches from \_\_\_\_\_ to \_\_\_\_\_ ft.  
 • Mesh size \_\_\_\_\_ Type \_\_\_\_\_  
 • \_\_\_\_\_ inches from \_\_\_\_\_ to \_\_\_\_\_ ft.  
 • Mesh size \_\_\_\_\_ Type \_\_\_\_\_  
 • Gravel Pack  
 New From \_\_\_\_\_ to \_\_\_\_\_ ft.  
 Not From \_\_\_\_\_ to \_\_\_\_\_ ft.  
 • Grout  
 From 115 to 0 ft. Type Cement  
 From 124 to 115 ft. Type Rock Cuttings


WATER DATA • Water Temperature \_\_\_\_\_ °  
 • Static water level (unpumped level-measured) 92'  
 • Stabilized measured pumping water level \_\_\_\_\_  
 • Stabilized yield 15 gpm after 1/4 hours  
 Natural Flow: Yes \_\_\_\_\_ No  flow rate: \_\_\_\_\_ gpm  
 Comment on quality Clear  
 3. WATER ZONES: From \_\_\_\_\_ To \_\_\_\_\_  
 From 180 To 183 From 218 To 226  
 From 234 To 240 From \_\_\_\_\_ To \_\_\_\_\_  
 USE DATA:  
 Type of use: Drinking  Livestock Watering \_\_\_\_\_  
 Irrigation \_\_\_\_\_ Food processing \_\_\_\_\_ Household   
 Manufacturing \_\_\_\_\_ Fire Safety \_\_\_\_\_ Cleaning \_\_\_\_\_  
 Recreation \_\_\_\_\_ Aesthetic \_\_\_\_\_ Cooling or heating \_\_\_\_\_  
 Injection \_\_\_\_\_ Other \_\_\_\_\_  
 • Type of facility Domestic  Public water supply \_\_\_\_\_  
 Public institution \_\_\_\_\_ Farm \_\_\_\_\_ Industry \_\_\_\_\_  
 Commercial \_\_\_\_\_ Other \_\_\_\_\_  
 5. PUMP DATA: Type \_\_\_\_\_ • Rated H.P. \_\_\_\_\_  
 • Intake depth \_\_\_\_\_ • Capacity \_\_\_\_\_ at \_\_\_\_\_ head  
 6. WELLHEAD: Type well seal \_\_\_\_\_  
 Pressure Tank \_\_\_\_\_ gal. Loc \_\_\_\_\_  
 Sample tap \_\_\_\_\_ Measurement port \_\_\_\_\_  
 Well vent \_\_\_\_\_ Pressure relief valve \_\_\_\_\_  
 Gate valve \_\_\_\_\_ Check valve (when required) \_\_\_\_\_  
 Electrical disconnect switch on power supply \_\_\_\_\_  
 7. DISINFECTION: Well disinfected \_\_\_\_\_ Yes \_\_\_\_\_ No \_\_\_\_\_  
 Date \_\_\_\_\_ Disinfectant used \_\_\_\_\_  
 Amount \_\_\_\_\_ Hours used \_\_\_\_\_  
 8. ABANDONMENT (where applicable) • Yes \_\_\_\_\_ No \_\_\_\_\_  
 Casing pulled Yes \_\_\_\_\_ No \_\_\_\_\_ Not Applicable \_\_\_\_\_  
 Plugging grout From \_\_\_\_\_ to \_\_\_\_\_ material \_\_\_\_\_

9. State law requires submitting to the Virginia State Water Control Board information about groundwater and wells for every well made to the intended for water, or any other non-exempt well. This information must be submitted whether the well is completed, on standby, or abandoned. Information required includes: an accurately and completely prepared water well completion report, full data from any aquifer pumping tests, drill cuttings taken at ten foot intervals (unless exemption is secured), the results of any chemical analysis, and copies of any geophysical logs. Quarterly pumpage and test reports are required from owners of public supply and industrial wells. County or State permits to drill may be required in some parts of the state. Some counties require submission of a water well completion report. The Virginia State Health Department requires a water well completion report for public supply wells.

10. DRILLERS LOG (use additional sheets if necessary)

DEPTH (feet)		TYPE OF ROCK OR SOIL (color, material, fossils, hardness etc.)	REMARKS (water, caving, cavities, broken, cone, shot, etc.)
From	To		
0	104'	Red Dier + Red Clay	Soft
104'		Blue Stone	med - Hard
234'	240'	Quartz + Blue stone	med.

11. Drilling Time (Min.)

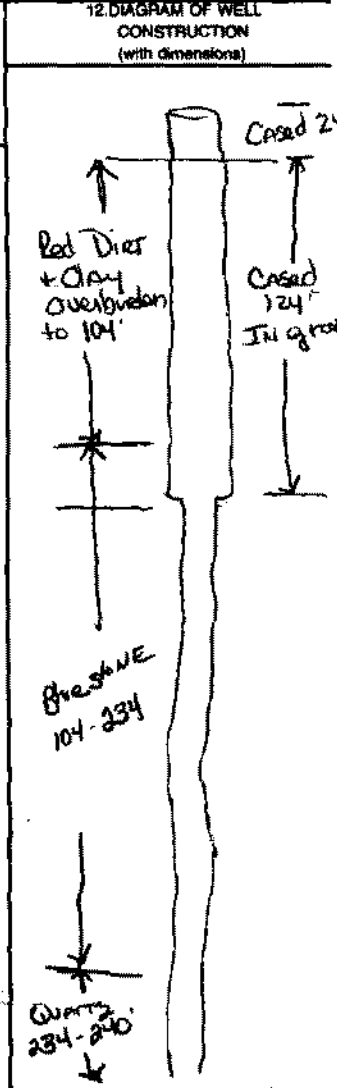

State Water Control Board Regional Offices

Valley Reg. Off.  
118 North Main Street  
P.O. Box 288  
Bristol, Va. 22812  
703-628-2695

Piedmont Reg. Off.  
4010 West Broad Street  
P.O. Box 6616  
Richmond, Va. 23230  
804-257-1008

Southwest Reg. Off.  
406 East Main Street  
P.O. Box 478  
Abingdon, Va. 24210  
703-628-5183

Tidewater Reg. Off.  
287 Pembroke Office Park  
Suite 310 Pembroke No. 2  
Va. Beach, Va. 23462  
804-499-8742

West Central Reg. Off.  
Executive Park  
5312 Peters creek Road  
Roanoke, Va. 24019  
703-982-7432

Northern Virginia Reg. Off.  
5516 Cherokee Avenue  
Suite 404  
Alexandria, Va. 22312  
703-750-9111

13. Well lot dedicated? \_\_\_\_\_ : Size \_\_\_\_\_ ft. x \_\_\_\_\_ ft. Well house? \_\_\_\_\_  
Distance to nearest pollutant source \_\_\_\_\_ ft., Type \_\_\_\_\_  
Distance to nearest property line \_\_\_\_\_ ft., Building \_\_\_\_\_ ft.

14. WATER SERVICE PIPE: Checked under \_\_\_\_\_ P.S.I. for \_\_\_\_\_  
minutes. Pipe size \_\_\_\_\_ inches, Material \_\_\_\_\_  
Installer \_\_\_\_\_  
Date \_\_\_\_\_

15. I certify that the information contained herein is true and correct and that this well and/or system has been installed and constructed in accordance with the requirements for well construction as specified in compliance with appropriate county or independent city ordinances and the laws and rules of the Commonwealth of Virginia.

Signature Wade A. [Signature] (Seal) Date 10/20/96  
(Well driller or authorized person)  
License No. 015640