

Uniform Water Well Completion Report

Fredericksburg, Va. 22401
371-8017 Page 1877-8136

Owner Richard Sullivan / For Sale
Address 40 Curtis Estates
Fredericksburg, Va. 22401
Phone 371-8017
Location Small Estates #8 off 662 Far Side of Curtis Mem. Park
Well Classification IIIA IIIB IIIC IV
Approx 3/4 M. North of Inter 616/662 Well Data *

Tax Map ID 26 Gr-8
VDH Permit SWP-96-249
VWCB Permit _____
VWCB ID _____
County STAFFORD
7/17/96 Rob Snyder
SFF

General Information
Drilling Method 160
Depth to Bedrock 80
Static Water Level 40
Well Disinfected (Y or N) _____

Date Completed 11/22/96
Yield 30 (GPM)
Stabilized Water Level 80
Disinfectant Used _____

Total Depth of Well 160
Length of Test approx 1 Hr.
Natural Flow (Rate) _____
Amount Used _____

Casing
From 71 To 80
Size 4 1/4 Material P.V.C.
Weight/Schedule S.D.R. 27

From 72 To 120
Size 4" Material P.V.C.
Weight/Schedule Sch 40

From 140 To 160
Size 4" Material P.V.C.
Weight/Schedule Sch. 40

Gravel Pack
From _____ To _____
Hole size 10" From 0 to 60 ft.
Grout
From 0 To 50+
Bore Hole Size 10"
Type Bentonite 11/196
Method Pressure Grouting

From _____ To _____
Hole size 7 1/8" From 60 to 80 ft.
From _____ To _____
Bore Hole Size _____
Type _____
Method _____

From _____ To _____
Hole size 6 1/8" From 80 to 160 ft.
From _____ To _____
Bore Hole Size _____
Type _____
Method _____

Water Zones or Screened Intervals
From 120 To 140
Mesh Size 0.20 Diam 4" P.V.C.
From _____ To _____
Mesh Size _____ Diam _____

approx water zone
From 129 To 130
Mesh Size _____ Diam _____
From _____ To _____
Mesh Size _____ Diam _____

From _____ To _____
Mesh Size _____ Diam _____
From _____ To _____
Mesh Size _____ Diam _____

* Use Data *

Private Well: Domestic Agricultural _____ Industrial _____ Monitoring _____
Public Well: Community _____ Non Community _____

11/25/96
1/2 H.P. STA Rite Sub.
105P400 Stainless steel
23-02
1296 F
WX 250

* Abandonment Information *

Bored or Dug Wells
Casing Removed, Y or N? _____
If Y, Depth to which casing was removed: _____
Depth and Type of Fill: _____
Source of Fill: _____
Bentonite Plugs: From _____ to _____ From _____ to _____

Wells other than Bored Wells
Casing removed, Y or N? _____
Depth to which casing was removed: _____
Applicable, depth(s), and type of gravel/sand fill: _____
Source of gravel or sand: _____
Cement: From _____ to _____ From _____ to _____

Method of permanently marking location:
 Installed watertight top
Suggest setting pump @ approx 100 ft.

You will encounter 4" casing @ approx. 72 Ft.
Suggest keeping centralizers & torque arrestors out of
4" casing

Larry Richard Sullivan
For Sale

Saugatucket Est. # 8
Stafford


* Drillers Log

Depth

Description of Formation or Sediment

Remarks

0	10	Red Clay	
10	30	Micaceous formation / Red	
30	60	Micaceous formation / Brown	
60	80	Brown Shale	set 4" P.V.C. Well Casing screen due to the softness of the formation
80	160	Blue Shale	

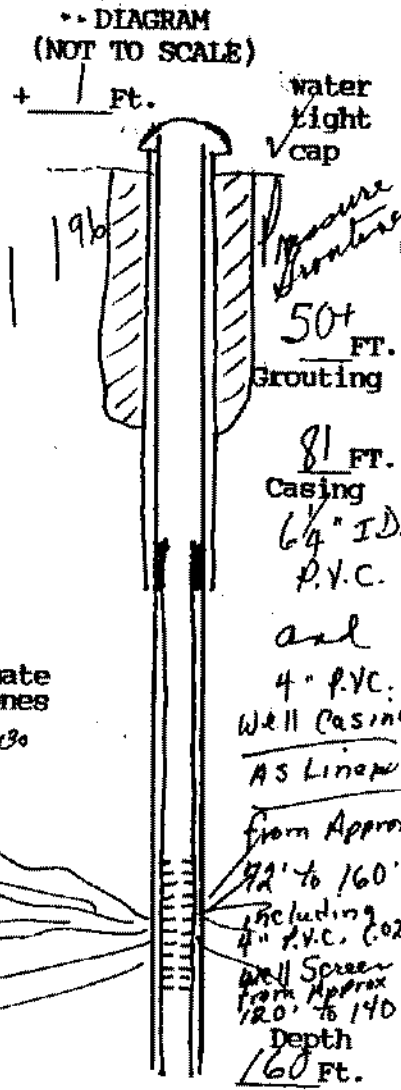

Approximate Water Zones
129 & 130

(User additional Sheets if necessary)

I certify that the information contained here is true and that this well was installed and constructed in accordance with the permit and further that the well complies with all applicable state and local regulations, ordinances and laws.

Name JOHN L. DANIELSON, JR., INC.
Address 4616 HOOD DRIVE
FREDERICKSBURG, VIRGINIA 22408
Phone 570 (203) 898-6025 / 898-9355

Drillers Signature Anna M. Danielson President
Date 11/25/96 Representing JOHN L. DANIELSON, JR., INC.

Virginia Contractors License Number CLASS A 2701 014084A H/H WWC