

Marissa Holmes
4121 Whites Cross Court
Fredericksburg, VA 22408
891-8124 F 894-4407

Commonwealth of Virginia
Uniform Water Well Completion Report

Owner Lesetha Long
Address _____
Phone 373-1274
Location # 612
(Approx 1/4 M. N of Inter 7 649 # 612)
Well Classification IIIA IIIB IIIC IV
* Well Data *

Tax Map ID R 26-17 X
VDH Permit SWP-97-376
VWCB Permit _____
VWCB ID _____
County Stafford
10/7/97 Asker Weight
SFF

General Information
Drilling Method Air Rotary
Depth to Bedrock 80'
Static Water Level _____
Well Disinfected (Y or N) _____

Date Completed 1/20/98
Yield 20 (GPM)
Stabilized Water Level _____
Disinfectant Used _____

Total Depth of Well 220'
Length of Test approx 1 Hr.
Natural Flow (Rate) _____
Amount Used _____

Casing
From +1 To 107
Size 6 1/4 Material P.V.C.
Weight/Schedule SDR 27

From 107 To 127
Size 6 1/8 Material P.V.C.
Weight/Schedule SDR 21

From 120 aka 180 To 220
Size 4 Material P.V.C.
Weight/Schedule Sc L 40

Gravel Pack
From _____ To _____
Hole size 10" from 0 to 60 ft.
Grout
From 0 To 50+
Bore Hole Size 10"
Type Bentonite 1/26/98
Method Pressure Grouting

From _____ To _____
Hole size 7 7/8" from 60 to 127 ft.
Grout
From _____ To _____
Bore Hole Size _____
Type _____
Method _____

From _____ To _____
Hole size 6 1/8" from 127 to 220 ft.
Grout
From _____ To _____
Bore Hole Size _____
Type _____
Method _____

Water Zones or Screened Intervals
From 180 To 200
Mesh Size .020 Diam 4" (P.V.C.)
From _____ To _____
Mesh Size _____ Diam _____

From approx water zone 190 To 199
Mesh Size _____ Diam _____
From _____ To _____
Mesh Size _____ Diam _____

From _____ To _____
Mesh Size _____ Diam _____
From _____ To _____
Mesh Size _____ Diam _____

* Use Data *

Private Well: Domestic Agricultural _____ Industrial _____ Monitoring _____
Public Well: Community _____ Non Community _____

* Abandonment Information *

Bored or Dug Wells
Casing Removed, Y or N? _____
If Y, Depth to which casing was removed: _____
Depth and Type of Fill: _____
Source of Fill _____
Bentonite Plugs: From _____ to _____ From _____ to _____

Wells other than Bored Wells
Casing removed, Y or N? _____
Depth to which casing was removed: _____
Applicable, depth(s), and type of gravel/sand fill: _____
Source of gravel or sand: _____
Cement: From _____ to _____ From _____ to _____

Method of permanently marking location: _____
 Installed watertight top
Suggest setting pump @ approx. 100 ft.


4" P.V.C. Well Casing - as listed - will begin @ approx

John Stafford
Service Worker
Louella Long
Stafford
 #612

* Drillers Log *

Depth	Description of Formation or Sediment	Remarks
0	10	Red Clay
10	40	Micaceous formation / Red
40	60	Micaceous formation / Brown
60	80	Harder Brown Micaceous formation
80	127	Brown Shale
127	220	Blue Shale

set 4" P.V.C. Well Casing & Screen - as level - due to softness of the formation.

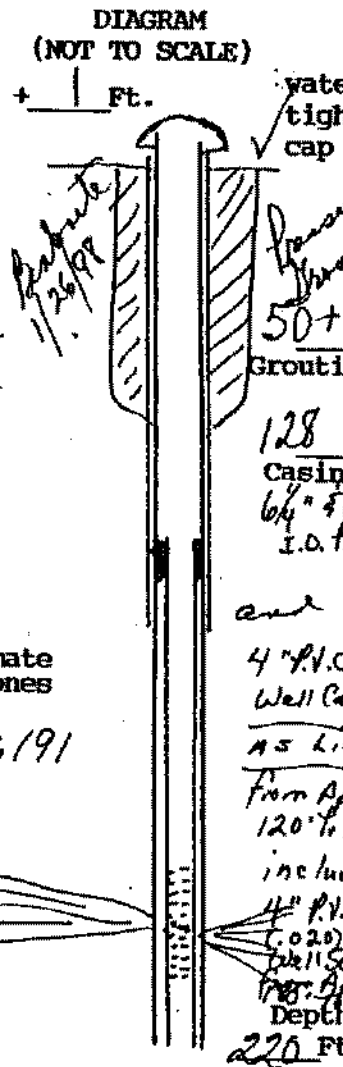

Approximate Water Zones

190 to 191

(User additional Sheets if necessary)

I certify that the information contained here is true and that this well was installed and constructed in accordance with the permit and further that the well complies with all applicable state and local regulations, ordinances and laws.

Name JOHN L. DANIELSON, JR., INC.
 Address 4616 HOOD DRIVE
FREDERICKSBURG, VIRGINIA 22408
 Phone 540 (703) 898-6025 / 898-9355

Drillers Signature John L. Danielson, Pres
 Date 1/26/98 Representing JOHN L. DANIELSON, JR., INC.

Virginia Contractors License Number CLASS A 2701 014084A H/H WVC