

Bob Sharcliff

Davidson Horner

3601 Frank Road Smith 395 Commonwealth of Virginia

Spadesburg, Va 22407 Uniform Water Well Completion Report

898-4800

Fax 898-5632

269-11B

Owner Davidson Horner (For Sale)

Address 3601 Frank Rd - Smith 395

Spadesburg, Va 22407

Phone 898-4800

Location 2 miles on right

Well Classification IIIA IIIB IIIC IV

Tax Map ID 266-118

VDH Permit SWP-97-75

VWCB Permit

VWCB ID

County Stafford

71377 Box 54

* Well Data *

General Information

Drilling Method Augering

Depth to Bedrock 35

Static Water Level 30

Well Disinfected (Y or N) _____

Date Completed 7/7/97

Yield 10 (GPM)

Stabilized Water Level 260

Disinfectant Used _____

Total Depth of Well 260'

Length of Test approx 1 hr

Natural Flow (Rate) _____

Amount Used _____

Casing

From tl To 97

Size 4" Material P.V.C.

Weight/Schedule S.D.R. 27

From _____ To _____

Size _____ Material _____

Weight/Schedule _____

From _____ To _____

Size _____ Material _____

Weight/Schedule _____

Gravel Pack

From _____ To _____

Hole size _____

Grout _____

From _____ To _____

Bore Hole Size _____

Type Bentonite

Method Pressure Grouting

From _____ To _____

Hole size 7 1/8" from 60 to 97 ft.

Grout _____

From _____ To _____

Bore Hole Size _____

Type _____

Method _____

From _____ To _____

Hole size 6 1/8" from 97 to 260 ft.

Grout _____

From _____ To _____

Bore Hole Size _____

Type _____

Method _____

Water Zones or Screened Intervals

From 160 To 161

Mesh Size _____ Diam _____

From 240 To 241

Mesh Size _____ Diam _____

From _____ To _____

Mesh Size _____ Diam _____

From _____ To _____

Mesh Size _____ Diam _____

From _____ To _____

Mesh Size _____ Diam _____

From _____ To _____

Mesh Size _____ Diam _____

* Use Data *

Private Well: Domestic

Public Well: Community _____

Agricultural _____

Non Community _____

Industrial _____

Monitoring 1

* Abandonment Information *

Bored or Dug Wells

Casing Removed, Y or N? _____

If Y, Depth to which casing was removed: _____

Depth and Type of Fill: _____

Source of Fill _____

Bentonite Plugs: From _____ to _____ From _____ to _____

Wells other than Bored Wells

Casing removed, Y or N? _____

Depth to which casing was removed: _____

Applicable, depth(s), and type of gravel/sand fill: _____

Source of gravel or sand: _____

Cement: From _____ to _____ From _____ to _____


Method of permanently marking location: _____

Installed waterlight top

Suggest setting pump @ approx 200 ft.

Tranquil Home
Tranquil Cat # 118
Stafford
 17 → 616 → 622 (Stoney Hill) - 2 Miles on Right
 * Drillers Log *

Depth	Description of Formation or Sediment	Remarks
0 10	Red Clay	
10 55	Brown Clay	
55 130	Brown Shale	
130 260	Gray Granite	

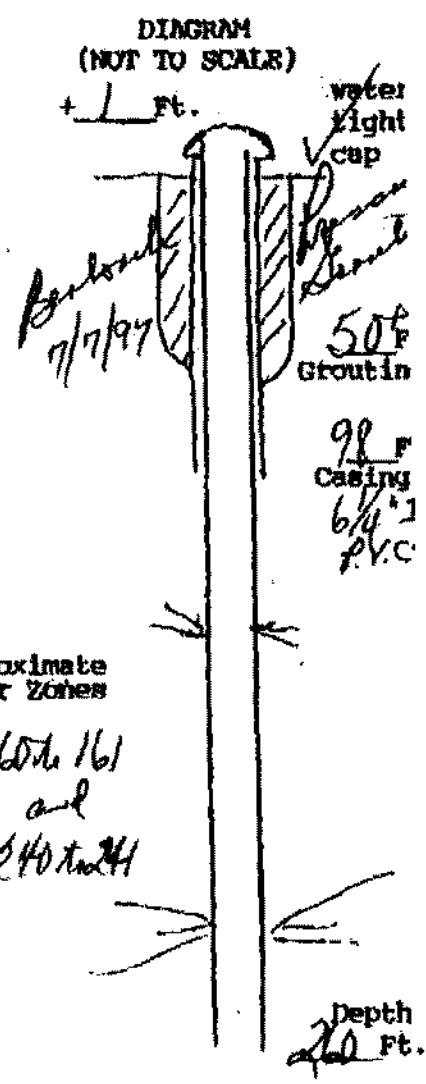

(Use additional Sheets if necessary)

I certify that the information contained here is true and that this well was installed and constructed in accordance with the permit and further that the well complies with all applicable state and local regulations, ordinances and laws.

Name JOHN L. DANIELSON, JR., INC.
 Address 4616 HOOD DRIVE*
FREDERICKSBURG, VIRGINIA 22406
 Phone 570 (233) 898-6025 / 898-9355

Drillers Signature John Danielson President
 Date 7/7/97 Representing JOHN L. DANIELSON, JR., INC.

Virginia Contractors License Number CLASS A 2701 014084A H/II WMC