

9. State law requires submitting to the Virginia State Water Control Board information about groundwater and wells for every well made in the state intended for water, or any other non-exempt well. This information must be submitted whether the well is completed, on standby, or abandoned. Information required includes: an accurately and completely prepared water well completion report, full data from any aquifer pumping tests, drill cuttings taken at ten foot intervals (unless exemption is secured), the results of any chemical analysis, and copies of any geophysical logs. Quarterly pumpage and use reports are required from owners of public supply and industrial wells. County or State permits to drill may be required in some parts of the state. Some counties require submission of a water well completion report. The Virginia State Health Department requires a water well completion report for public supply wells.


10. DRILLERS LOG (use additional sheets if necessary)

DEPTH (feet)		TYPE OF ROCK OR SOIL (color, material, fossils, hardness etc.)	REMARKS (water, casing, cavities, broken, cone, shot, etc.)
From	To		
0	50	overburden (clay + shale) blue shale gravel formation	tried to drill rest hrs. part this formation to see if it would stop casing. After 4 hours of not being able to get past formation + continuous flows of water over 75 gpm we decided to use this water. Although the 15' depth into gravel will not stay open its making so much water that hanging pump @ bottom of hole should be fine
50	65		
65	80		

11. Drilling Time (Min.)

4 hrs

12. DIAGRAM OF WELL CONSTRUCTION (with dimensions)

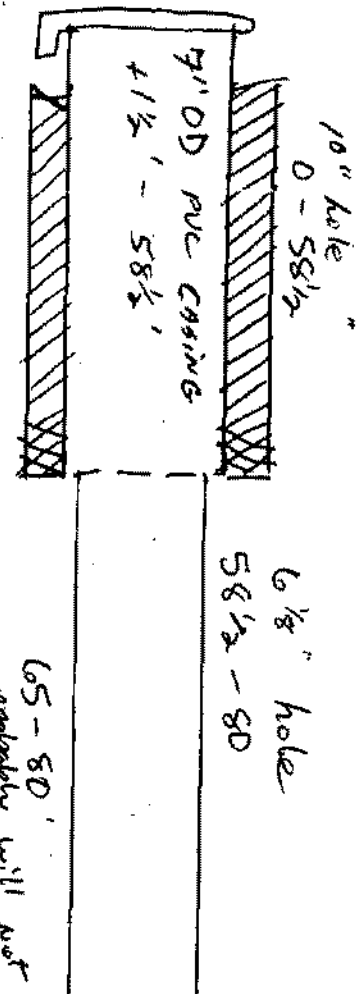

State Water Control Board Regional Offices

Valley Reg. Off.
116 North Main Street
P.O. Box 268
Bridgewater, Va. 22812
703-828-2595

Piedmont Reg. Off.
4010 West Broad Street
P.O. Box 6618
Richmond, Va. 23230
804-257-1006

Southwest Reg. Off.
408 East Main Street
P.O. Box 476
Abington, Va. 24210
703-628-5183

Tidewater Reg. Off.
287 Pembroke Office Park
Suite 310 Pembroke No. 2
Va. Beach, Va. 23462
804-499-8742

West Central Reg. Off.
Executive Park
5312 Peters creek Road
Roanoke, Va. 24019
703-982-7432

Northern Virginia Reg. Off.
5515 Cherokee Avenue
Suite 404
Alexandria, Va. 22312
703-750-9111

13. Well lot dedicated? _____; Size _____ ft. x _____ ft.; Well house? _____

Distance to nearest pollutant source _____ ft., Type _____

Distance to nearest property line _____ ft., Building _____ ft.

14. WATER SERVICE PIPE: Checked under _____ P.S.I. for _____

minutes. Pipe size _____ inches, Material _____

Installer _____

Date _____

15. I certify that the information contained herein is true and correct and that this well and/or system has been installed and constructed in accordance with the requirements for well construction as specified in compliance with appropriate county or independent city ordinances and the laws and rules of the Commonwealth of Virginia.

Signature Wade N. Driffin (Seal) Date 11/13/08

License No. 27050 46112