

Commonwealth of Virginia
Uniform Water Well Completion Report



Owner Jennings Lester
Address 205 Club House Rd.
Farmington, VA
Phone (540) 368-2860
Location Beverly Estates Lot # 5

Tax Map ID 26 H-5
VDH Permit SWP-99-632
VWCB Permit _____
VWCB ID _____
County Stafford

* Well Data *

General Information

Drilling Method Air Rotary
Depth to Bedrock 55'
Static Water Level 25'
Well Disinfected (Y or N) N

Date Completed 5/24/00
Yield 30 (GPM)
Stabilized Water Level _____
Disinfectant Used _____

Total Depth of Well 280'
Length of Test 1 hr.
Natural Flow (Rate) N
Amount Used _____

Casing From +1 1/2' To 68 1/2'
Size 6 3/4" ID Material PVC
Weight/Schedule 3.441 lb/ft.
.250 wall

From _____ To _____
Size _____ Material _____
Weight/Schedule _____

From _____ To _____
Size _____ Material _____
Weight/Schedule _____

Gravel Pack

From _____ To _____

From _____ To _____

From _____ To _____

Grout From 60' To 0
Bore Hole Size 10" x 6 3/4"
Type Resonite E-2 sand
Method pressure grout from bottom to top

From 68 1/2' To 60'
Bore Hole Size 10" x 6 3/4"
Type backfill sand with type
Method from back of drill

From _____ To _____
Bore Hole Size _____
Type _____
Method _____

Water Zones or Screened Intervals

From 230' To 233'
Mesh Size _____ Diam _____
From _____ To _____
Mesh Size _____ Diam _____

From 270' To 271'
Mesh Size _____ Diam _____
From _____ To _____
Mesh Size _____ Diam _____

From _____ To _____
Mesh Size _____ Diam _____
From _____ To _____
Mesh Size _____ Diam _____

* Use Data *

Private Well: Domestic Agricultural _____ Industrial _____ Monitoring _____
Public Well: Community _____ Non Community _____

* Abandonment Information *

Bored or Dug Wells

Casing Removed, Y or N? _____
Y Depth to which casing was removed: _____
Depth and Type of Fill _____
Source of Fill _____
Bentonite Plugs: From _____ to _____ From _____ to _____

Wells other than Bored Wells

Casing removed, Y or N? _____
Depth to which casing was removed: _____
Applicable, depth(s), and type of gravel/sand fill: _____
Source of gravel or sand: _____
Cement: From _____ to _____ From _____ to _____


Method of permanently marking location: _____

Drillers Log

Description of Formation or Sediment

Not To Scale
Remarks

0-20' red clay
 20'-30' brown clay
 30'-50' brown sandy clay
 50'-65' brown schist
 65'-280' grey slate

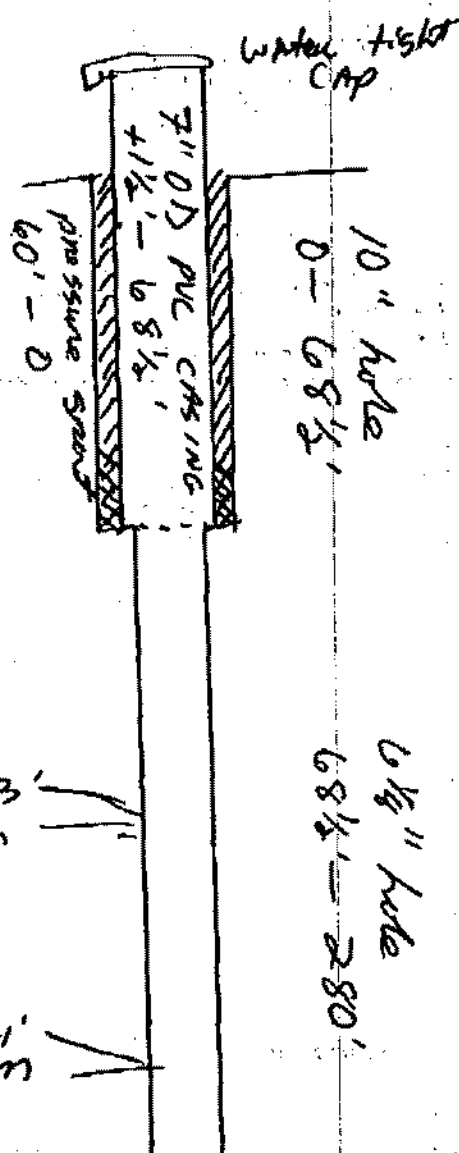

230-233'
5 GPM

270'-271'
25+ GPM

(Use additional Sheets if necessary)

I certify that the information contained here is true and that this well was installed and constructed in accordance with the permit and regulations and complies with all applicable state and local regulations, ordinances and laws.

Company: Antonian Water Wells, Inc.
 Address: 11412 Garden Rd. Fairfax VA 22407

Phone: (540) 795-8163

Driller's Signature: Wade N. [Signature]
 Date: 5/24/00 Representing AWWE

Driller's License Number: 2705-046112