

Wyatt
766 Mtn. View Rd.
Stafford, VA 22406

Commonwealth of Virginia
Uniform Water Well Completion Report



Owner: Jim Laska + Jeanna Nash
Address: 771 Kellogg Mill Rd.
657-4870
Phone: _____
Location: Gawtlet Estates Lot # 3

Tax Map ID: 26B-3
VDH Permit: SWT-01-112
VWCB Permit: _____
VWCB ID: _____
County: Stafford

Well Classification: IIIA _____ IIIB IIIC _____ IV _____
* Well Data *

General Information
Drilling Method: Air Rotary
Depth to Bedrock: 60'
Static Water Level: 25'
Well Disinfected (Y or N): N

Date Completed: 7/19/01
Yield: 30.7 (GPM)
Stabilized Water Level: _____
Disinfectant Used: _____

Total Depth of Well: 120'
Length of Test: 1 hr.
Natural Flow (Rate): N
Amount Used: _____

Casing
From +1 1/2' To 108 1/2'
Size: 6 1/4" ID Material: PVC
Weight Schedule: 3.491 # per ft.
.250 wall

From _____ To _____
Size _____ Material _____
Weight Schedule _____

From _____ To _____
Size _____ Material _____
Weight Schedule _____

Gravel Pack
From _____ To _____
Gravel Size: _____
From _____ to _____ ft.
From 60' To 0
Bore Hole Size: 10" X 10 1/2"
Type: Bentonite E-2 seal
Method: pressure grout from bottom to top

From _____ To _____
From 108 1/2' To 60'
Bore Hole Size: 10" X 10 1/2"
Type: rock cuttings +
Method: natural cave-in

From _____ To _____
From _____ To _____
Bore Hole Size: _____
Type: _____
Method: _____

Water Zones or Screened Intervals
From 120' To 100'
Mesh Size: 0.080 Diam: 4 1/2"

From _____ To _____
Mesh Size _____ Diam _____

From _____ To _____
Mesh Size _____ Diam _____

* Use Data *

Private Well: Domestic Agricultural _____ Industrial _____ Monitoring _____
Public Well: Community _____ Non Community _____

* Abandonment Information *

Bored or Dig Wells
Casing Removed: Y or N? _____
Depth to which casing was removed: _____
Depth and Type of Fill: _____
Source of Fill: _____
Reinforce Drags: From _____ to _____ From _____ to _____

Wells other than Bored Wells
Casing removed, Y or N? _____
Depth to which casing was removed: _____
Applicable, depth(s), and type of gravel/sand fill: _____
Source of gravel or sand: _____
Cement: From _____ to _____ From _____ to _____


Method of permanently marking location: _____
 Installed watertight top

Depth

Description of Formation or Sediment

Remarks

0	10'	brown sandy clay
10'	60'	red sandy clay
60'	80'	real soft brown rock
80'	90'	broken-up quartz (w) sand
90'	110'	soft grey rock
110'	120'	grey granite

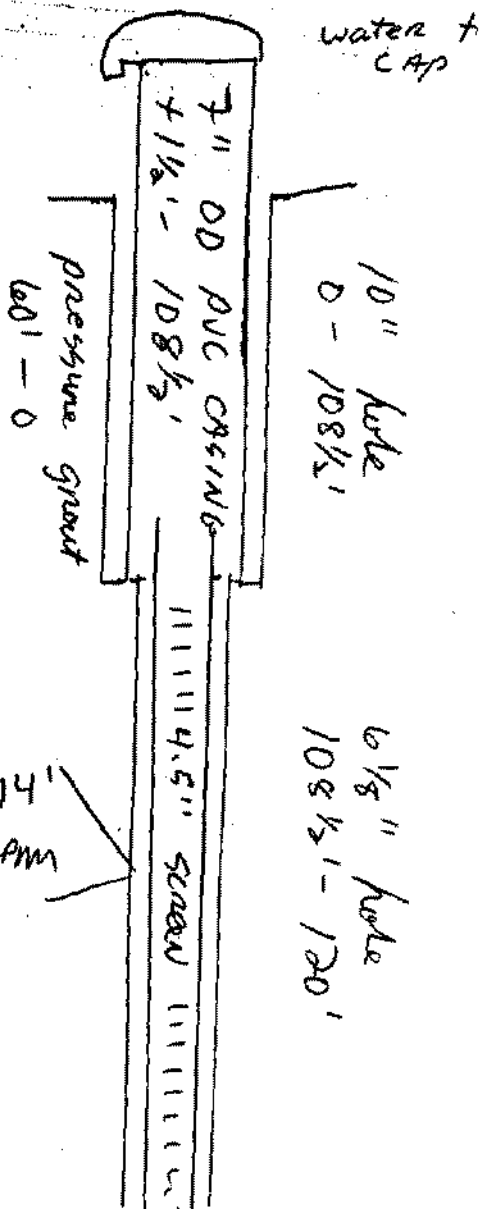

112' - 114'
30+ GAM

(Use additional Sheets if necessary)

I hereby certify that the information contained here is true and that this well was installed and constructed in accordance with the permit and that the well complies with all applicable state and local regulations, ordinances and laws.

Company: ARTESIAN WATER WELLS, INC.
 Address: 11412 GORDON RD
F. BURG VA 22407
 Phone: (540) 785-8163

Driller's Signature: Wade N. Duff
 Date: 7/19/01 Representing: A.W.W.J.

Driller's License Number: 2705-046112