

Commonwealth of Virginia  
Uniform Water Well Completion Report

Owner Joseph Winslow  
Address P.O. Box  
Phone \_\_\_\_\_  
Location Lot #1 Walden Ten

Tax Map ID 26-D1  
VDH Permit WS-92-106  
VWCB Permit \_\_\_\_\_  
VWCB ID \_\_\_\_\_  
County Stafford

\* Well Data \*

General Information

Drilling Method Air rotary  
Depth to Bedrock 60  
Static Water Level 15  
Well Disinfected (Y or N) N

Date Completed 5-5-93  
Yield 100+ (GPM)  
Stabilized Water Level \_\_\_\_\_  
Disinfectant Used \_\_\_\_\_

Total Depth of Well 105  
Length of Test 2  
Natural Flow (Rate) \_\_\_\_\_  
Amount Used \_\_\_\_\_

Casing

From +1 to 72  
Size 6 1/2" Material PVC  
Weight/Schedule Sch 40

From \_\_\_\_\_ to \_\_\_\_\_  
Size \_\_\_\_\_ Material \_\_\_\_\_  
Weight/Schedule \_\_\_\_\_

From \_\_\_\_\_ to \_\_\_\_\_  
Size \_\_\_\_\_ Material \_\_\_\_\_  
Weight/Schedule \_\_\_\_\_

Gravel Pack

From \_\_\_\_\_ to \_\_\_\_\_

From \_\_\_\_\_ to \_\_\_\_\_

From \_\_\_\_\_ to \_\_\_\_\_

Grout

From 50 to 0  
Bore Hole Size 10  
Type Neat  
Method Pressure

From \_\_\_\_\_ to \_\_\_\_\_  
Bore Hole Size \_\_\_\_\_  
Type \_\_\_\_\_  
Method \_\_\_\_\_

From \_\_\_\_\_ to \_\_\_\_\_  
Bore Hole Size \_\_\_\_\_  
Type \_\_\_\_\_  
Method \_\_\_\_\_

Water Zones or Screened Intervals

From 90 to 105  
Mesh Size \_\_\_\_\_ Diam. \_\_\_\_\_  
From \_\_\_\_\_ to \_\_\_\_\_  
Mesh Size \_\_\_\_\_ Diam. \_\_\_\_\_

From \_\_\_\_\_ to \_\_\_\_\_  
Mesh Size \_\_\_\_\_ Diam. \_\_\_\_\_

\* Use Data \*

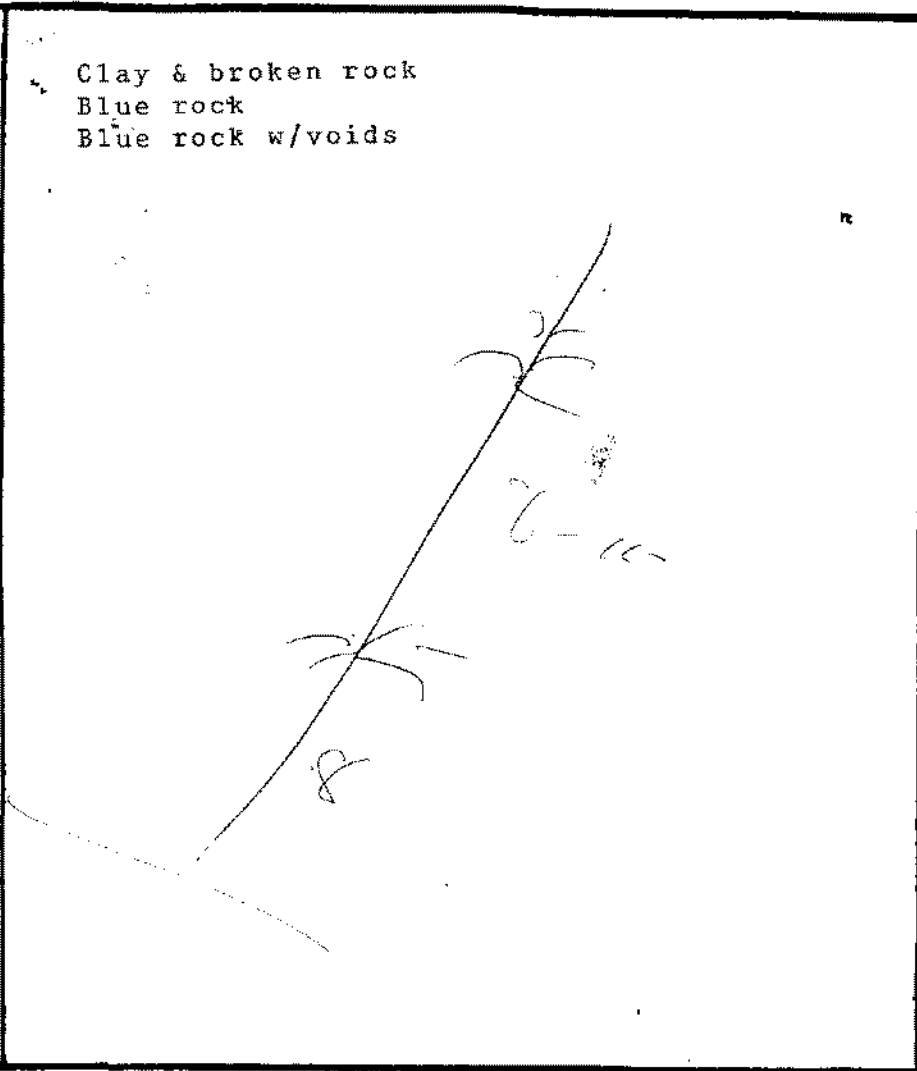
Private Well: Domestic X Agricultural \_\_\_\_\_ Industrial \_\_\_\_\_ Monitoring \_\_\_\_\_  
Public Well: Community \_\_\_\_\_ Non Community \_\_\_\_\_

(Use additional sheets if necessary)

Commonwealth of Virginia  
Department of Water Resources  
Application State

Depth

Description of Formation or Sediment

<p>0-60 60-90 90-105</p>	<p>Clay &amp; broken rock Blue rock Blue rock w/voids</p> 	<p>Water bearing</p>
----------------------------------	---	----------------------

I certify that the information contained here is true and that this well was installed and constructed in accordance with the permit and further that the well complies with all applicable state and local regulations, ordinances and laws.

**Drilling**

Contractor Van's Construction Co., Inc.

Address P.O. Box 3306

Fredericksburg, VA 22402

Phone 373-7502

Drillers Signature *W. Wilson* Date 5-5-93

Representing Van's Const. Co., Inc.

Virginia Contractors License Number 2701-018610A