

**Commonwealth of Virginia
Uniform Water Well Completion Report**

Owner Jerry Stone / TWS Builders For Sale
 Address P.O. Box 1074
Locust Grove, Va. 22508
 Phone 972-0607 / Casper, W. 371-1787 Fax 877-9148
 Location Cannon Knolls #. 36 (662 #6 616)

Tax Map ID 26F-36
 VDH Permit WS-93-325
 VWCB Permit _____
 VWCB ID _____
 County Stafford
11/30/95 Rob Snydman
10/30/93 TT Thompson

Well Classification IIIA IIIB IIIC IV
 Approx. 1 M. West Intersection of 662 & 616 * Well Data *
 " 100' North of 662

General Information
 Drilling Method Air Rotary
 Depth to Bedrock 65
 Static Water Level 40
 Well Disinfected (Y or N) _____

Date Completed 6/21/94
 Yield 20 (GPM)
 Stabilized Water Level 71 " 100"
 Disinfectant Used _____

Total Depth of Well 200
 Length of Test approx 1 Hr.
 Natural Flow (Rate) _____
 Amount Used _____

casing
 From 1 To 75
 Size 6 1/2" Material P.V.C.
 Weight/Schedule SDR 29

From _____ To _____
 Size _____ Material _____
 Weight/Schedule _____

From _____ To _____
 Size _____ Material _____
 Weight/Schedule _____

Level Pack
 From _____ To _____
 size _____
 from 0 to 75 ft.
 cut _____
 From 0 To 60'
 Bore Hole Size 10" 6/23/94
 Type Bentonite
 Method Pressure Grouting

From _____ To _____
 size 6 1/2" from 75 to 200 ft.
 From _____ To _____
 Bore Hole Size _____
 Type _____
 Method _____

From _____ To _____
 " from _____ to _____ ft.
 From _____ To _____
 Bore Hole Size _____
 Type _____
 Method _____

Screened Intervals
 From 100 To 101
 Mesh Size _____ Diam _____
 From 180 To 181
 Mesh Size _____ Diam _____

From _____ To _____
 Mesh Size _____ Diam _____
 From _____ To _____
 Mesh Size _____ Diam _____

From _____ To _____
 Mesh Size _____ Diam _____
 From _____ To _____
 Mesh Size _____ Diam _____

* Use Data *

Private Well: Domestic Agricultural _____ Industrial _____ Monitoring _____
 Public Well: Community _____ Non Community _____

* Abandonment Information *

Bored or Dug Wells
 Being Removed, Y or N? _____
 Depth to which casing was removed: _____
 Material and Type of Fill: _____
 Source of Fill _____
 Concrete Plugs: From _____ to _____ From _____ to _____


Wells other than Bored Wells
 Casing removed, Y or N? _____
 Depth to which casing was removed: _____
 Applicable, depth(s), and type of gravel/sand fill: _____
 Source of gravel or sand: _____
 Cement: From _____ to _____ From _____ to _____

Method of permanently marking location: _____
 Installed watertight top _____
 Suggest setting pump @ approx. 140 ft.

3/4 H.P. 10 G.P.M.
Red Jacket Sab
WX 203 Tank

Perry Home / TWS Builders / For Sale
 Canyon Knolls # 36
 Stafford #662 off 616
 Near Entrance to Carter Memorial Park
 Drillers Log

Depth	Description of Formation or Sediment	Remarks
0	10	Red Clay
10	65	Brown Clay
65	75	Soft Brown Rock
75	200	Light Gray Rock

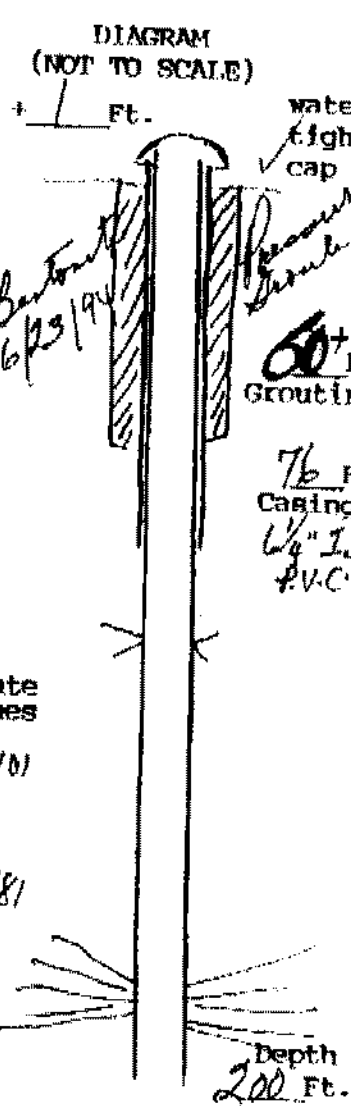

Approximate Water Zones
 100 to 101
 and
 180 to 181

(Use additional Sheets if necessary)

I certify that the information contained here is true and that this well was installed and constructed in accordance with the permit and other that the well complies with all applicable state and local regulations, ordinances and laws.

Name JOHN L. DANIELSON, JR., INC.
 Address 4616 HOOD DRIVE
FREDERICKSBURG, VIRGINIA 22408
 Phone (703) 898-6025 / 898-9355

Drillers Signature John L. Danielson, Jr.
 6/23/94 Representing JOHN L. DANIELSON, JR., INC.

Virginia Contractors License Number CLASS A 2701 014084A II/II WVC