

**Commonwealth of Virginia
Uniform Water Well Completion Report**

Owner James Michael Berry
 Address 484 Crapp Rd Hartwood Va 22406
 Phone 752-2480 B&H Millwork # 752-2269
 Location 612 (2 miles South of #616) 1124 Hartwood Road
183C 34M S. of Inter 7 691 ft 612
 Well Classification IIIA IIIB IIIC IV

Tax Map ID 26-4A
 VDH Permit WS-53-351
 VWCB Permit _____
 VWCB ID _____
 County Stafford
1/14/94 Rot Snyder
1/20/94 T.J. Thompson

* Well Data *

General Information

Drilling Method Air Rotary Date Completed 8/29/94
 Depth to Bedrock 80 Yield 25 (GPM)
 Static Water Level approx 20' Stabilized Water Level approx 140'
 Well Disinfected (Y or N) _____ Disinfectant Used _____

Total Depth of Well 220'
 Length of Test approx 1 HR.
 Natural Flow (Rate) _____
 Amount Used _____

Casing

From 71 To 111' From 95' To 180
 Size 6 3/4 Material Steel Size 4" Material P.V.C
 Weight/Schedule 188/1316 pps ft. Weight/Schedule Sch 40

From 200 To 220
 Size 4" Material P.V.C
 Weight/Schedule Sch 40

Gravel Pack

From _____ To _____ From _____ To _____

Hole size 10" from 0 to 60 ft. 7 7/8" from 60 to 111 ft.

Grout From 0 To 50' From _____ To _____
 Bore Hole Size 10" Bore Hole Size _____
 Type Bentonite Type _____
 Method Pressure Grouting Method _____

6 1/2" from 111 to 220 ft.

Water Zones or Screened Intervals

From 180 To 200 From 182' To 183'
 Mesh Size .020 Diam 4" (P.V.C.) Mesh Size _____ Diam _____
 From _____ To _____ From _____ To _____
 Mesh Size _____ Diam _____ Mesh Size _____ Diam _____

* Use Data *

Private Well: Domestic Agricultural _____ Industrial _____ Monitoring _____
 Public Well: Community _____ Non Community _____

* Abandonment Information *

Bored or Dug Wells

Casing Removed, Y or N? _____
 If Y, Depth to which casing was removed: _____
 Depth and Type of Fill: _____
 Source of Fill _____
 Bentonite Plugs: From _____ to _____ From _____ to _____

Wells other than Bored Wells

Casing removed, Y or N? _____
 Depth to which casing was removed: _____
 Applicable, depth(s), and type of gravel/sand fill: _____
 Source of gravel or sand: _____
 Cement: From _____ to _____ From _____ to _____

Method of permanently marking location: _____


Installed watertight top
 Suggest setting pump @ approx. 160 ft.
You will encounter 4" casing @ approx 95'
Suggest keeping centralizers & torque arrestors out of 4" casing

Mike Barry
1124 Harlow Rd
Stafford
VA 22152

Department of Virginia
 "At Risk" Compliance

* Drillers Log *

Depth	Description of Formation or Sediment	Remarks
0	10	Red Clay
10	40	Micaceous formation / Red
40	75	Micaceous formation / Brown
75	111	Brown Shale { set 4" PVC & Screen due to the softness
111	220	Blue Shale { of the formation

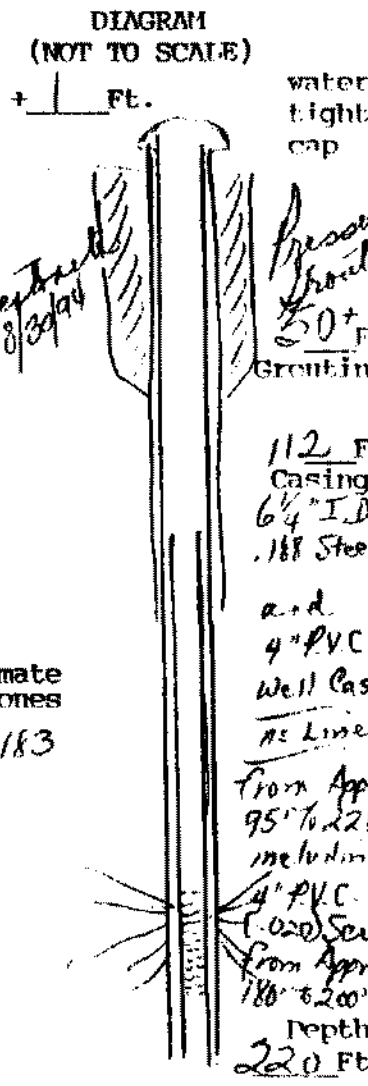

Approximate Water Zones
 182 to 183

(User additional Sheets if necessary)

I certify that the information contained here is true and that this well was installed and constructed in accordance with the permit and further that the well complies with all applicable state and local regulations, ordinances and laws.

Name JOHN L. DANIELSON, JR., INC.
 Address 4616 HOOD DRIVE
FREDERICKSBURG, VIRGINIA 22408
 Phone (703) 898-6025 / 898-9355

Drillers Signature John L. Danielson Pres.
 Date 8/30/94 Representing JOHN L. DANIELSON, JR., INC.

Virginia Contractors License Number CLASS A 2701 014084A II/II WMC