

Commonwealth of Virginia

Uniform Water Well Completion Report

Home Builders Inc  
103 Chewning Lane  
Fredericksburg Va 22401  
785-8333/F 785-8538  
Owner Collegewood Properties / For Sale  
Address 4800 Cwell Rd.  
Fredericksburg Va 22408-2642  
Phone 582-5001  
Location Cannon Knolls # 28 off 6628616

Tax Map ID 26F-28  
VDH Permit WS-94-10  
VWCB Permit \_\_\_\_\_  
VWCB ID \_\_\_\_\_  
County Stafford  
1/12/94 Rob Snyder  
1/12/94 T.Z. Thompson

Well Classification IIIA \_\_\_\_\_ IIIB  IIIC \_\_\_\_\_ IV \_\_\_\_\_  
\* Well Data \*

General Information

Drilling Method Air Rotary  
Depth to Bedrock 70  
Static Water Level 40  
Well Disinfected (Y or N) \_\_\_\_\_

Date Completed 8/17/94  
Yield 15 (GPM)  
Stabilized Water Level 760'  
Disinfectant Used \_\_\_\_\_

Total Depth of Well 200'  
Length of Test approx 1 Hr  
Natural Flow (Rate) \_\_\_\_\_  
Amount Used \_\_\_\_\_

Casing

From +1 To 70  
Size 6 1/4 Material P.V.C.  
Weight/Schedule SDR 27

From \_\_\_\_\_ To \_\_\_\_\_  
Size \_\_\_\_\_ Material \_\_\_\_\_  
Weight/Schedule \_\_\_\_\_

From \_\_\_\_\_ To \_\_\_\_\_  
Size \_\_\_\_\_ Material \_\_\_\_\_  
Weight/Schedule \_\_\_\_\_

Gravel Pack

From \_\_\_\_\_ To \_\_\_\_\_  
Hole size 10" from 0 to 60 ft.

From \_\_\_\_\_ To \_\_\_\_\_  
Hole size 7 7/8" from 60 to 70 ft.

From \_\_\_\_\_ To \_\_\_\_\_  
Hole size 6 7/8" from 70 to 200 ft.

Grout From 0 To 60'  
Bore Hole Size 10"  
Type Bentonite  
Method Pressure Grouting

From \_\_\_\_\_ To \_\_\_\_\_  
Bore Hole Size \_\_\_\_\_  
Type \_\_\_\_\_  
Method \_\_\_\_\_

From \_\_\_\_\_ To \_\_\_\_\_  
Bore Hole Size \_\_\_\_\_  
Type \_\_\_\_\_  
Method \_\_\_\_\_

Water Zones or Screened Intervals

From 180 To 181  
Mesh Size \_\_\_\_\_ Diam \_\_\_\_\_  
From \_\_\_\_\_ To \_\_\_\_\_  
Mesh Size \_\_\_\_\_ Diam \_\_\_\_\_

From \_\_\_\_\_ To \_\_\_\_\_  
Mesh Size \_\_\_\_\_ Diam \_\_\_\_\_

\* Use Data \*

Private Well: Domestic  Agricultural \_\_\_\_\_ Industrial \_\_\_\_\_ Monitoring \_\_\_\_\_  
Public Well: Community \_\_\_\_\_ Non Community \_\_\_\_\_

\* Abandonment Information \*

Bored or Dug Wells

Casing Removed, Y or N? \_\_\_\_\_  
If Y, Depth to which casing was removed: \_\_\_\_\_  
Depth and Type of Fill: \_\_\_\_\_  
Source of Fill \_\_\_\_\_  
Bentonite Plugs: From \_\_\_\_\_ to \_\_\_\_\_ From \_\_\_\_\_ to \_\_\_\_\_


Wells other than Bored Wells

Casing removed, Y or N? \_\_\_\_\_  
Depth to which casing was removed: \_\_\_\_\_  
Applicable, depth(s), and type of gravel/sand fill: \_\_\_\_\_  
Source of gravel or sand: \_\_\_\_\_  
Cement: From \_\_\_\_\_ to \_\_\_\_\_ From \_\_\_\_\_ to \_\_\_\_\_

Method of permanently marking location: \_\_\_\_\_

Installed watertight top  
Suggest setting pump @ approx. 180 ft.

Jack Dety / Hometown Builders  
Cannon Kells #28  
Stafford  
 662 off 616

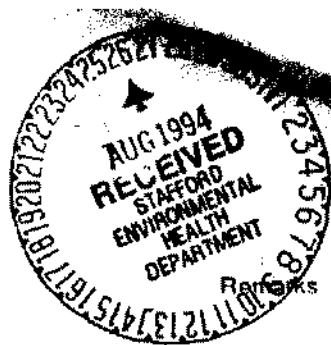


\* Drillers Log \*

Depth Description of Formation or Sediment

0	10	Red Clay
10	30	Micaceous Formation/Red
30	60	Micaceous Formation/Brown
60	70	Brown Shale
70	200	Blue Granite

DIAGRAM (NOT TO SCALE)

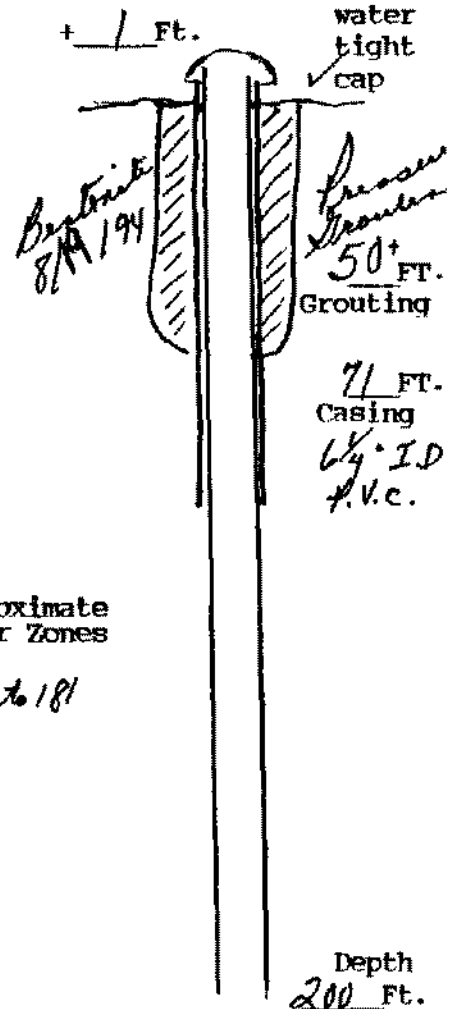

Approximate Water Zones

180 to 181

(User additional Sheets if necessary)

I certify that the information contained here is true and that this well was installed and constructed in accordance with the permit and further that the well complies with all applicable state and local regulations, ordinances and laws.

Name JOHN L. DANIELSON, JR., INC.  
 Address 4616 HOOD DRIVE  
FREDERICKSBURG, VIRGINIA 22408  
 Phone (703) 898-6025 / 898-9355

Drillers Signature Jack Danielson Pres.  
 Date 8/19/94 Representing JOHN L. DANIELSON, JR., INC.

Virginia Contractors License Number CLASS A 2701 014084A H/II WWC