

Paul Kearns  
Classical, Purchases Homes  
6307 Harrison Road  
Fredricksburg Va

Commonwealth of Virginia  
Uniform Water Well Completion Report

786-9795/786-0153  
22407-6363  
FAX 785-8188  
Owner Kelly Young  
Address \_\_\_\_\_

Tax Map ID 26F-49  
VDH Permit WS-94-14  
VWCB Permit \_\_\_\_\_  
VWCB ID \_\_\_\_\_  
County STAFFORD  
1/12/94 Rob Sugden  
" T.T. Thompson

Phone \_\_\_\_\_  
Location Cannon Knolls # 49

Well Classification IIIA \_\_\_\_\_ IIIB  IIIC \_\_\_\_\_ IV \_\_\_\_\_  
\* Well Data \*

General Information

Drilling Method Air Rotary  
Depth to Bedrock 119  
Static Water Level approx 40'  
Well Disinfected (Y or N) \_\_\_\_\_

Date Completed 8/10/94  
Yield 12 (GPM)  
Stabilized Water Level approx 180'  
Disinfectant Used \_\_\_\_\_

Total Depth of Well 220  
Length of Test approx 1 Hr  
Natural Flow (Rate) \_\_\_\_\_  
Amount Used \_\_\_\_\_

Casing From +1 To 99  
Size 6 1/4 Material P.V.C.  
Weight/Schedule SDR 27

From 99 To 119  
Size 6 1/4 Material P.V.C.  
Weight/Schedule SDR 21

113' to 180'  
and  
From 200 To 220  
Size 4" Material P.V.C.  
Weight/Schedule Sch 40

Gravel Pack

From \_\_\_\_\_ To \_\_\_\_\_

From \_\_\_\_\_ To \_\_\_\_\_

From \_\_\_\_\_ To \_\_\_\_\_

Hole size 10" From 0 to 60 ft.

7 7/8" From 60 to 119 ft.

6 1/8" From 119 to 220 ft.

Grout From 0 To 60+  
Bore Hole Size 10  
Type Bentonite  
Method Pressure Grouting

From \_\_\_\_\_ To \_\_\_\_\_  
Bore Hole Size \_\_\_\_\_  
Type \_\_\_\_\_  
Method \_\_\_\_\_

From \_\_\_\_\_ To \_\_\_\_\_  
Bore Hole Size \_\_\_\_\_  
Type \_\_\_\_\_  
Method \_\_\_\_\_

Water Zones or Screened Intervals

From 180 To 200  
Mesh Size .020 Diam 4" P.V.C.  
From \_\_\_\_\_ To \_\_\_\_\_  
Mesh Size \_\_\_\_\_ Diam \_\_\_\_\_

From 190 To 191  
Mesh Size \_\_\_\_\_ Diam \_\_\_\_\_  
From \_\_\_\_\_ To \_\_\_\_\_  
Mesh Size \_\_\_\_\_ Diam \_\_\_\_\_

From \_\_\_\_\_ To \_\_\_\_\_  
Mesh Size \_\_\_\_\_ Diam \_\_\_\_\_  
From \_\_\_\_\_ To \_\_\_\_\_  
Mesh Size \_\_\_\_\_ Diam \_\_\_\_\_

\* Use Data \*

Private Well: Domestic  Agricultural \_\_\_\_\_ Industrial \_\_\_\_\_ Monitoring \_\_\_\_\_  
Public Well: Community \_\_\_\_\_ Non Community \_\_\_\_\_

\* Abandonment Information \*

Bored or Dug Wells

Casing Removed, Y or N? \_\_\_\_\_  
If Y, Depth to which casing was removed: \_\_\_\_\_  
Depth and Type of Fill: \_\_\_\_\_  
Source of Fill \_\_\_\_\_  
Bentonite Plugs: From \_\_\_\_\_ to \_\_\_\_\_ From \_\_\_\_\_ to \_\_\_\_\_

Wells other than Bored Wells

Casing removed, Y or N? \_\_\_\_\_  
Depth to which casing was removed: \_\_\_\_\_  
Applicable, depth(s), and type of gravel/sand fill: \_\_\_\_\_  
Source of gravel or sand: \_\_\_\_\_  
Cement: From \_\_\_\_\_ to \_\_\_\_\_ From \_\_\_\_\_ to \_\_\_\_\_

Method of permanently marking location:

Installed watertight top  
Suggest setting pump @ approx. 200 ft.  
you will encounter 4" well casing @ approx 113'  
Suggest keeping torque arrestors & centralizers out of  
4" casing



*Paul Keane  
Classical Southern Area*

*Young  
Cannon Wells #49  
Stafford off 62 & W*

Drillers Log

Depth	Description of Formation or Sediment	Remarks
0	10	Red Clay
10	40	Micaceous formation / Red
40	90	Micaceous formation / Brown
90	119	Soft Brown Shale
119	220	Blue Shale

*set 4" P.V.C. due to the softness of the formation*

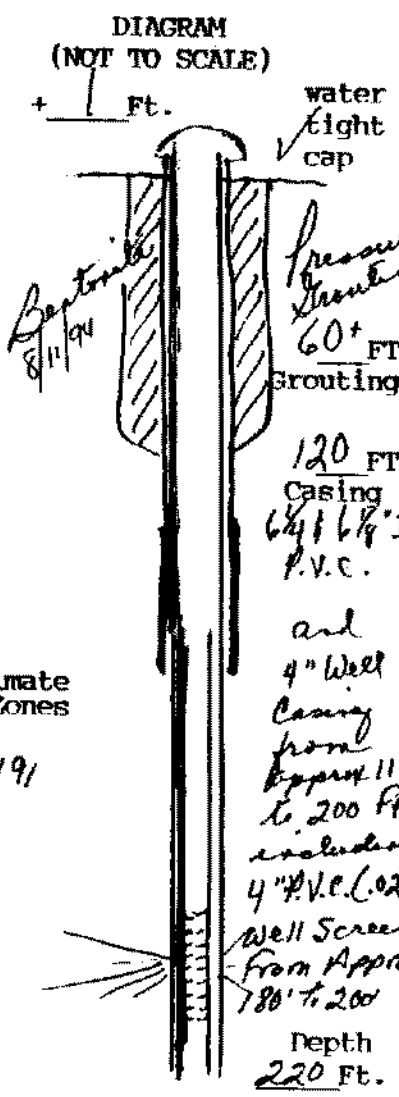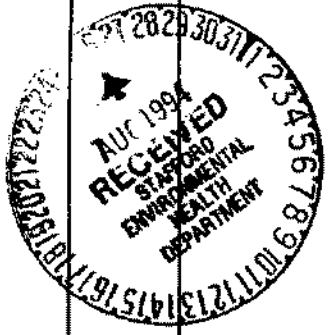

Approximate Water Zones  
190 to 191

(User additional Sheets if necessary)

I certify that the information contained here is true and that this well was installed and constructed in accordance with the permit and further that the well complies with all applicable state and local regulations, ordinances and laws.

Name JOHN L. DANIELSON, JR., INC.  
 Address 4616 HOOD DRIVE  
FREDERICKSBURG, VIRGINIA 22408  
 Phone (703) 898-6025 / 898-9355

Drillers Signature *John L. Danielson, Jr.*  
 Date 8/11/94 Representing JOHN L. DANIELSON, JR., INC.

Virginia Contractors License Number CLASS A 2701 014084A H/H WNC