

W. Hanson
Original Home Builders
P.O. Box 1615
Spotsylvania 22553
582-6361

Commonwealth of Virginia
Uniform Water Well Completion Report

Owner Stephen Hanson
Address _____

Tax Map ID 26F-11
VDH Permit WS-94-16
VWCB Permit _____
VWCB ID _____
County Stafford

Phone _____
Location Carson Knolls #11
183D
Well Classification IIIA IIIR IIIC IV
* Well Data *

S.F.F.

General Information
Drilling Method Aug Rotary
Date Completed 5/16/95
Depth to Bedrock 75'
Yield 20 (GPM)
Static Water Level 40'
Stabilized Water 40' 100'
Well Disinfected (Y or N) _____
Disinfectant Used _____

Total Depth of Well 220'
Length of Test approx 1 Hr.
Natural Flow (Rate) _____
Amount Used _____

Casing
From 4' To 75'
Size 6 1/4" Material P.V.C.
Weight/Schedule SDR 27

From _____ To _____
Size _____ Material _____
Weight/Schedule _____

Gravel Pack
From _____ To _____
Hole size 10" from 0 to 60' ft.
GROUT
From 0 To 60' 5/14/95
Bore Hole Size 10"
Type Bentonite
Method Pressure Grouting

From _____ To _____
Hole size 6 1/8" from 75 to 220 ft.
Bore Hole Size _____
Type _____
Method _____

Water Zones or Screened Intervals
From 120 To 121
Mesh Size _____ Diam _____
From 200 To 201
Mesh Size _____ Diam _____

From _____ To _____
Mesh Size _____ Diam _____
From _____ To _____
Mesh Size _____ Diam _____

* Use Data *

Private Well: Domestic Agricultural _____ Industrial _____ Monitoring _____
Public Well: Community Non Community _____

5/19/95
1/2 H.P. 10 GPM Sta. Rite
1 F94C
WY 250 Tank

* Abandonment Information *

Bored or Dug Wells
Casing Removed, Y or N?: _____
If Y, Depth to which casing was removed: _____
Depth and Type of Fill: _____
Source of Fill _____
Bentonite Plugs: From _____ to _____ From _____ to _____

Wells other than Bored Wells
Casing removed, Y or N? _____
Depth to which casing was removed: _____
Applicable, depth(s), and type of gravel/sand fill: _____
Source of gravel or sand: _____
Cement: From _____ to _____ From _____ to _____


Method of permanently marking location:
 Installed watertight top
Suggest setting pump @ approx. 120 ft.
941865 / Artillery Drive # 6 / 6/10/94
G. Goodpasture

Allen Hanson
George J. Bueler
Canon Wells #11
Stafford
 662 - off 17

* Drillers Log *

Depth	Description of Formation or Sediment	Remarks
0	10	Sandy Red Clay
10	40	Mucaceous formation / Red
40	60	Mucaceous formation / Brown
60	75	Brown Shale
75	220	Blue Granite

DIAGRAM
(NOT TO SCALE)

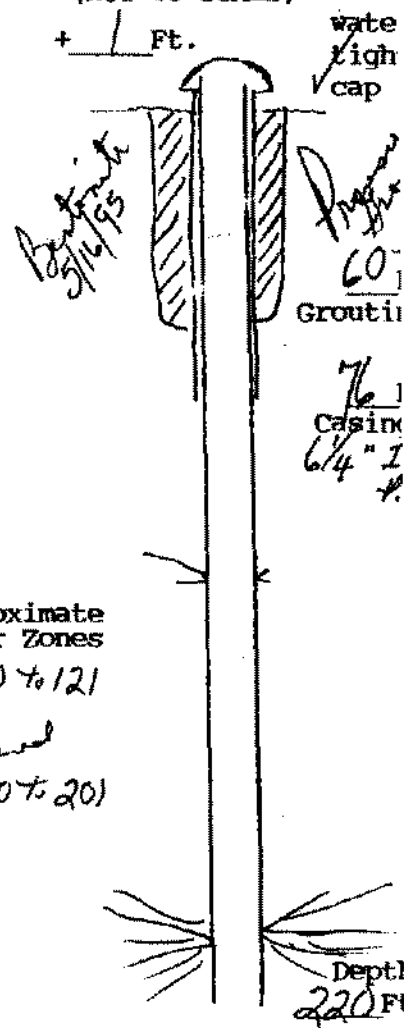

Approximate
Water Zones
120 to 121
and
200 to 201

(User additional Sheets if necessary)

I certify that the information contained here is true and that this well was installed and constructed in accordance with the permit and further that the well complies with all applicable state and local regulations, ordinances and laws.

Name JOHN L. DANIELSON, JR., INC.
 Address 4616 HOOD DRIVE
FREDERICKSBURG, VIRGINIA 22408
 Phone (703) 898-6025 / 898-9355

Drillers Signature John L. Danielson, Pres.
 Date 5/16/95 Representing JOHN L. DANIELSON, JR., INC.

Virginia Contractors License Number CLASS A 2701 014084A H/H WNC