

10. Box 1207
1 MAYAK Drive Suite #1
Stafford Va. 22554
720-6199 - H 972-0743

Commonwealth of Virginia
Uniform Water Well Completion Report

Owner Charles Catherine
Address HC #2 Box 250
Locust Grove, 22508
Phone 972-0743
Location Cannon Lindell #40 (011 #62)
183A
Well Classification IIIA IIIB IIIC IV
* Well Data *

Tax Map ID 26 F-40
VDH Permit WS-94-99
VWCB Permit _____
VWCB ID _____
County Stafford
3/22/94 Robert W. Wright
3/25/94 T. Thompson

SF

General Information
Drilling Method Air Rotary
Depth to Bedrock 62
Static Water Level 40'
Well Disinfected (Y or N) _____

Date Completed 8/15/74
Yield 25 (GPM)
Stabilized Water Level 60'
Disinfectant Used _____

Total Depth of Well 200'
Length of Test approx 1 Hr
Natural Flow (Rate) _____
Amount Used _____

Casing
From +1 To 62
Size 1 1/2" Material P.V.C.
Weight/Schedule SDR 27

From 50 To 180
Size 4" Material P.V.C.
Weight/Schedule SCL 40

From _____ To _____
Size _____ Material _____
Weight/Schedule _____

Gravel Pack
From _____ To _____
Hole size
10" from 0 to 62 ft.
Grout
From 0 To 50' 8/16/94
Bore Hole Size 10"
Type Bentonite
Method Pressure Grouting

From _____ To _____
Hole size
6 1/8" from 62 to 200 ft.
Grout
From _____ To _____
Bore Hole Size _____
Type _____
Method _____

From _____ To _____
Hole size _____
Grout
From _____ To _____
Bore Hole Size _____
Type _____
Method _____

Water Zones or Screened Intervals
From 180 To 200
Mesh Size 020 Diam 4" P.V.C.
From _____ To _____
Mesh Size _____ Diam _____

approx 1/2 in zone
From 182' To 183'
Mesh Size _____ Diam _____
From _____ To _____
Mesh Size _____ Diam _____

From _____ To _____
Mesh Size _____ Diam _____
From _____ To _____
Mesh Size _____ Diam _____

* Use Data *

Private Well: Domestic Agricultural _____ Industrial _____ Monitoring _____
Public Well: Community _____ Non Community _____

* Abandonment Information *

Bored or Dug Wells
Casing Removed, Y or N? _____
If Y, Depth to which casing was removed: _____
Depth and Type of Fill: _____
Source of Fill _____
Bentonite Plugs: From _____ to _____ From _____ to _____

Wells other than Bored Wells
Casing removed, Y or N? _____
Depth to which casing was removed: _____
Applicable, depth(s), and type of gravel/sand fill: _____
Source of gravel or sand: _____
Cement: From _____ to _____ From _____ to _____


Method of permanently marking location: _____
 Installed watertight top
Suggest setting pump @ approx. 120 ft.
you will encounter 4" casing @ approx 50 ft.
Suggest keeping centralizers & logline arrestors out of 4" casing

Cannon Knolls 40
Stafford 662

• Drillers Log •

| Depth | Description of Formation or Sediment | Remarks |
|--------|--------------------------------------|--------------------------------------------------------------|
| 0 10 | Red Clay | |
| 10 40 | Micaceous formation / Red | |
| 40 60 | Micaceous formation / Brown | |
| 60 62 | Brown Shale | |
| 62 200 | Blue Shale | Set 4" P.V.C. & Screen due to the softness of the formation. |

DIAGRAM
(NOT TO SCALE)

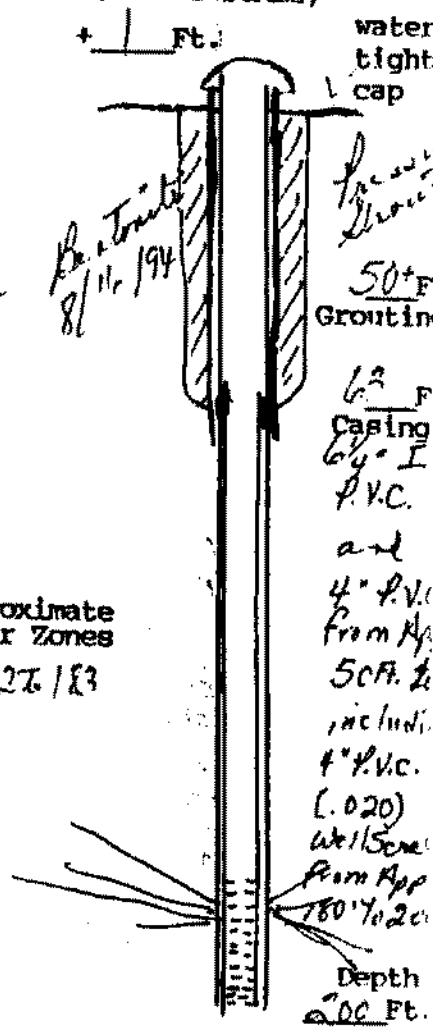

Approximate
Water Zones
182 to 183

(Use additional Sheets if necessary)

I certify that the information contained here is true and that this well was installed and constructed in accordance with the permit and further that the well complies with all applicable state and local regulations, ordinances and laws.

Name JOHN L. DANIELSON, JR., INC.
 Address 4616 HOOD DRIVE
FREDERICKSBURG, VIRGINIA 22408
 Phone (703) 898-6025 / 898-9355

Drillers Signature [Signature]
 Date 8/16/94 Representing JOHN L. DANIELSON, JR., INC.

Virginia Contractors License Number CLASS A 2701 014084A II/II WVC