

Robert French

110. Box 5179
Bedford, Va. 22403
371-1223 F 371-0283

Commonwealth of Virginia
Uniform Water Well Completion Report

Owner George S. Randall, Jr.
Address P.O. Box 124
Northwood, Va. 22471
Phone 752-9335

Tax Map ID 26-17C
VDH Permit W5R-92-186
VWCB Permit _____
VWCB ID _____

Location at Glade Near entrance to Pinner Park
183C Approx 1/2 Mile N of center of 6127649
Well Classification IIIA IIIB IIIC IV

County Stafford
6/19/92 Karl Rudolph
6/9/92 T.T. Thompson

* Well Data *

General Information
Drilling Method Air Rotary
Depth to Bedrock 80
Static Water Level 80
Well Disinfected (Y or N) _____

Date Completed 4/29/94
Yield 12 (GPM)
Stabilized Water Level 200
Disinfectant Used _____

Total Depth of Well 260'
Length of Test approx 1 Hr.
Natural Flow (Rate) _____
Amount Used _____

Casing
From 1 To 154
Size 6 1/2 Material Steel
Weight/Schedule 188/13lb. per ft.

From _____ To _____
Size _____ Material _____
Weight/Schedule _____

From _____ To _____
Size _____ Material _____
Weight/Schedule _____

Gravel Pack
From _____ To _____
Hole size 10" From 0 to 60 ft.
Grout From 0 To 50' 4/29/94
Bore Hole Size 10"
Type Barite
Method Pressure Grouting

From _____ To _____
Hole size 7 7/8" From 60 to 154 ft.
From _____ To _____
Bore Hole Size _____
Type _____
Method _____

From _____ To _____
Hole size 6 7/8" From 154 to 260 ft.
From _____ To _____
Bore Hole Size _____
Type _____
Method _____

Water Zones or Screened Intervals
From 251 To 252
Mesh Size _____ Diam _____
From _____ To _____
Mesh Size _____ Diam _____

From _____ To _____
Mesh Size _____ Diam _____

* Use Data *

Private Well: Domestic Agricultural _____ Industrial _____ Monitoring _____
Public Well: Community _____ Non Community _____

* Abandonment Information *

Bored or Dug Wells
Casing Removed, Y or N?: _____
If Y, Depth to which casing was removed: _____
Depth and Type of Fill: _____
Source of Fill _____
Bentonite Plugs: From _____ to _____ From _____ to _____

Wells other than Bored Wells
Casing removed, Y or N? _____
Depth to which casing was removed: _____
Applicable, depth(s), and type of gravel/sand fill: _____
Source of gravel or sand: _____
Cement: From _____ to _____ From _____ to _____

Method of permanently marking location:
 Installed watertight top
Suggest setting pump @ approx. 220 ft.

Trinity / Robert Greer

George G. Randall, Jr.


Stafford # 612

near entrance Curtis Men. Park
• Drillers Log •

Depth Description of Formation or Sediment Remarks

| | | |
|-----|-----|-----------------------------|
| 0 | 10 | Red Clay |
| 10 | 40 | Micaceous formation / Red |
| 40 | 80 | Micaceous formation / Brown |
| 80 | 154 | Brown Shale |
| 154 | 260 | Blue Granite |

DIAGRAM
(NOT TO SCALE)
+ Ft.

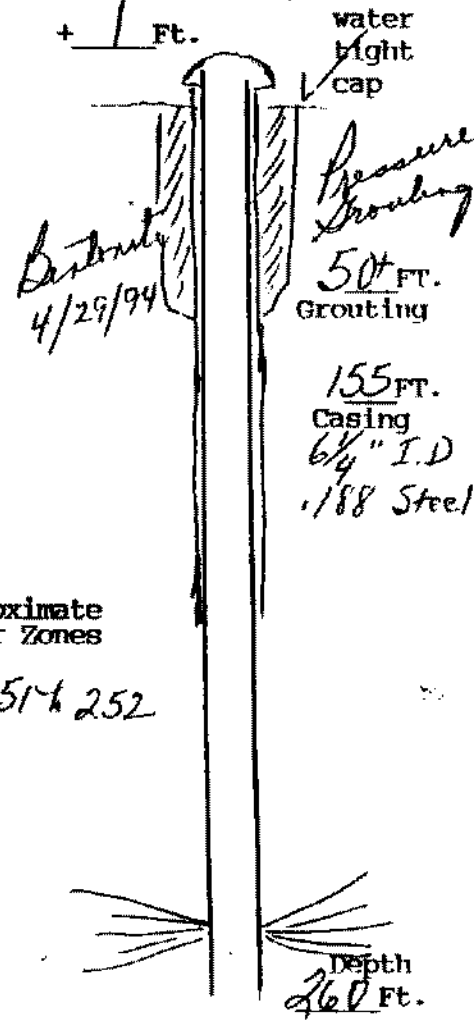

Approximate
Water Zones

251 + 252



(User additional Sheets if necessary)

I certify that the information contained here is true and that this well was installed and constructed in accordance with the permit and further that the well complies with all applicable state and local regulations, ordinances and laws.

Name JOHN L. DANIELSON, JR., INC.
 Address 4616 HOOD DRIVE
FREDERICKSBURG, VIRGINIA 22408
 Phone (703) 898-6025 / 898-9355

Drillers Signature John L. Danielson, Jr.
 Date 4/29/94 Representing JOHN L. DANIELSON, JR., INC.

Virginia Contractors License Number CLASS A 2701 014084A H/H WWC