

Owner Paul J. Ballenger


Completion S. 10 min. 10 min. 10 min.

9. State law requires submitting to the Virginia State Water Control Board information about groundwater and wells for every well made in the Commonwealth of Virginia intended for water, or any other non-exempt well. This information must be submitted whether the well is completed, on standing or abandoned. Information required includes: an accurately and completely prepared water well completion report, full data from any aquifer pumping tests, or cuttings taken at ten foot intervals (unless exemption is secured), the results of any chemical analyses, and copies of any geophysical logs. Completed pumping and use reports are required from owners of public supply and industrial wells. County or State permits to drill may be required in some parts of the state. Some counties require submission of a water well completion report. The Virginia State Health Department requires a water well completion report for public supply wells.

10. DRILLERS LOG (use additional Sheets if necessary) 11. 12. DIAGRAM OF WELL CONSTRUCTION (with dimensions)

DEPTH (feet)		TYPE OF ROCK OR SOIL (color, material, fossils, hardness, etc.)	REMARKS (water, caving, cavities, broken, core, shot, etc.)	Drilling Time (Min.)
From	To			
0	88	Brown soil blue rock.		
88	205			

Well 205 ft
100 ft casing
50 ft grout

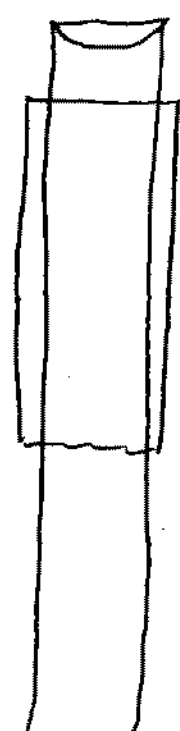

13. Well lot dedicated? Size ft. X ft.; Well house?
 Distance to nearest pollutant source ft., Type
 Distance to nearest property line ft., Building ft.

14. WATER SERVICE PIPE: Checked under p.s.i. for minutes. Pipe size inches, Material
 Installer
 Date

15. I certify that the information contained herein is true and correct and that this well and/or system has been installed and constructed in accordance with the requirements for well construction as specified in compliance with appropriate county or independent city ordinances and the laws and rules of the Commonwealth of Virginia.

State Water Control Board Regional Offices

- | | |
|--|--|
| <p>Valley Reg. Off.
116 North Main Street
P. O. Box 268
Bridgewater, Va. 22812
703-828-2595</p> <p>Southwest Reg. Off.
408 East Main Street
P. O. Box 476
Abingdon, Va. 24210
703-828-5183</p> <p>West Central Reg. Off.
Executive Park
3312 Peters Creek Road
Roanoke, Va. 24019
703-982-7432</p> | <p>Piedmont Reg. Off.
4010 West Broad Street
P. O. Box 6616
Richmond, Va. 23230
804-257-1006</p> <p>Tidewater Reg. Off.
287 Pembroke Office Park
Suite 310 Pembroke No. 2
Va. Beach, Va. 23462
804-499-8742</p> <p>Northern Virginia Reg. Off.
5515 Cherokee Avenue
Suite 404
Alexandria, Va. 22312
703-750-9111</p> |
|--|--|

Signature Raymond J. Curtis (Seal) Date 9/7/89
 (Well driller or authorized person) License No.