

**Commonwealth of Virginia
Uniform Water Well Completion Report**

Virginia Department of
Professional Professions
Division of Geology
1000 Bankers Building
Richmond, VA 23219
703-295-6100
DCH/STW/TC 01-2004

Michael J. Staker
10 Jubilee Rd
Stafford
Phone 659-6084 w/ (702) 553-4743
Location Lakeford Inset 1-1A
183A
Well Classification IIIA IIIB IIIC IV

Permit issued to:
Carl Frazer
6599 Commonwealth Court/Suite 100
Manassasville, Va. 22065
703-349-5500
Stafford 659/Bedford Road

Tax Map ID 27A-1-1A
VDH Permit 189-99-78
WVCB Permit _____
WVCB ID _____
County Stafford
6/28/99 Chris Nardoudis

* Well Data *

General Information

Drilling Method air Rotary
Depth to Bedrock 87
Static Water Level 40
Well Disinfected (Y or N) _____

Date Completed 6/23/93
Yield 12 (GPM)
Stabilized Water Level 160
Disinfectant Used _____

Total Depth of Well 200
Length of Test 1 Hr
Natural Flow (Rate) _____
Amount Used _____

Casing

From 14 To 87
Size 1 1/4 Material PVC
Weight/Schedule SDR 27

From _____ To _____
Size _____ Material _____
Weight/Schedule _____

From _____ To _____
Size _____ Material _____
Weight/Schedule _____

Gravel Pack

From _____ To _____

From _____ To _____

From _____ To _____

Hole size
10" from 0 to 70 ft.

7 1/8" from 70 to 87 ft.

6 1/8" from 87 to 200 ft.

Grout

From 0 To 25+ ft
Bore Hole Size 10
Type Bentonite
Method Pressure Grouting

From _____ To _____
Bore Hole Size _____
Type _____
Method _____

From _____ To _____
Bore Hole Size _____
Type _____
Method _____

Water Zones or Screened Intervals

From 181 To 182
Mesh Size _____ Diam _____
From _____ To _____
Mesh Size _____ Diam _____

From _____ To _____
Mesh Size _____ Diam _____

* Use Data *

Private Well: Domestic Agricultural _____ Industrial _____ Monitoring _____
Public Well: Community _____ Non Community _____

* Abandonment Information *

Bored or Dug Wells

Casing Removed, Y or N?: _____
If Y, Depth to which casing was removed: _____
Depth and Type of Fill: _____
Source of Fill: _____
Bentonite Plugs: From _____ to _____ From _____ to _____

Wells other than Bored Wells

Casing removed, Y or N? _____
Depth to which casing was removed: _____
Applicable, depth(s), and type of gravel/sand fill: _____
Source of gravel or sand: _____
Cement: From _____ to _____ From _____ to _____


Method of permanently marking location: _____
 Installed watertight top
Suggest setting pump @ approx. 180 ft.

Michael Steker
 Lakeland Forest 1-1A
 Seaside
 off #650 & Lakeland Rd.
 Drillers Log

Name of Company/Corporation/Individual: J.L. Danielson, Jr.
 Name: J.L. Danielson, Jr.
 Address: 4616 Hood Drive
 Fredericksburg, Virginia 22408
 Phone: (703) 898-6025 / 898-9355

Depth Description of Formation or Sediment Remarks

0	10	Red Clay
10	30	Micaceous formation / red
30	70	Micaceous formation / brown
70	87	Soft Brown Shale
87	200	Blue Gravel

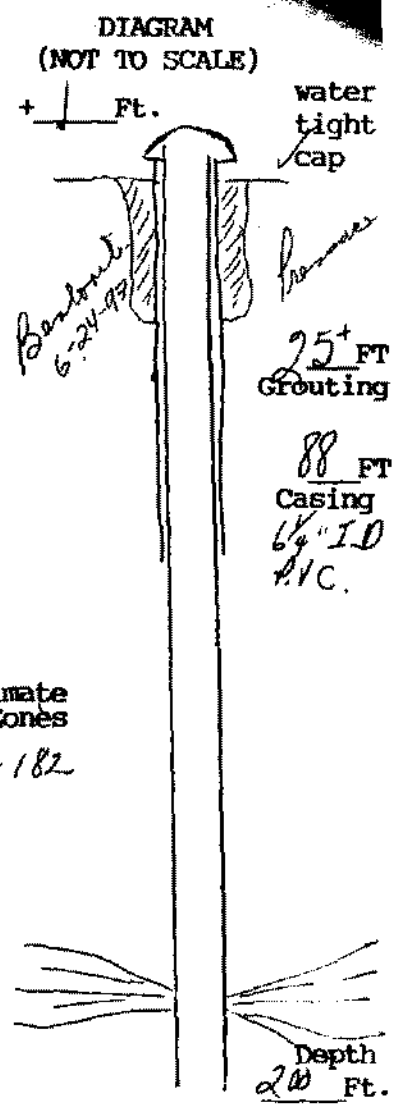

(User additional Sheets if necessary)

I certify that the information contained here is true and that this well was installed and constructed in accordance with the permit and further that the well complies with all applicable state and local regulations, ordinances and laws.

Name JOHN L. DANIELSON, JR., INC.
 Address 4616 HOOD DRIVE
FREDERICKSBURG, VIRGINIA 22408
 Phone (703) 898-6025 / 898-9355

Drillers Signature [Signature]
 Date 6/24/93 Representing JOHN L. DANIELSON, JR., INC.

Virginia Contractors License Number CLASS A 2701 014084A H/H WWC