

Sub 109-37
Commonwealth of Virginia
Uniform Water Well Completion Report

Address Walbill Limited Partnership
2892 Jefferson Davis Highway
Stafford, Virginia
 Phone 11720-5751
 Location Richard Eas #3 (#640) Stephanie Rd.
 Well Classification IIIA IIIB IIIC IV

Tax Map ID 27-15-3
 VDH Permit SWP-95-189
 VWCB Permit _____
 VWCB ID _____
 County STAFFORD
6/16/95 Rob Snyder
DJC

* Well Data *

General Information

Drilling Method Air Rotary Date Completed 8/15/95 Total Depth of Well 300'
 Depth to Bedrock 56 Yield 5 (GPM) Length of Test approx 1 Hr
 Static Water Level 40 Stabilized Water Level 260 Natural Flow (Rate) _____
 Well Disinfected (Y or N) _____ Disinfectant Used _____ Amount Used _____

Casing

From <u>+1</u> To <u>72</u>	From _____ To _____	From _____ To _____
Size <u>6 1/2</u> Material <u>P.V.C.</u>	Size _____ Material _____	Size _____ Material _____
Weight/Schedule <u>SDR 27</u>	Weight/Schedule _____	Weight/Schedule _____

Gravel Pack

From _____ To _____	From _____ To _____	From _____ To _____
---------------------	---------------------	---------------------

Hole size

10" from 0 to 72 ft. 6 1/8" from 72 to 300 ft. _____ " from _____ to _____ ft.

Grout

From <u>0</u> To <u>60'</u>	From _____ To _____	From _____ To _____
-----------------------------	---------------------	---------------------

Bore Hole Size

<u>10"</u>	<u>15 3/8"</u>	_____	_____
------------	----------------	-------	-------

Type

<u>Bentonite</u>	_____	_____	_____
------------------	-------	-------	-------

Method

<u>Pressure Grouting</u>	_____	_____	_____
--------------------------	-------	-------	-------

Water Zones or Screened Intervals

From <u>180</u> To <u>181</u>	From _____ To _____	From _____ To _____
Mesh Size _____ Diam _____	Mesh Size _____ Diam _____	Mesh Size _____ Diam _____
From <u>260</u> To <u>261</u>	From _____ To _____	From _____ To _____
Mesh Size _____ Diam _____	Mesh Size _____ Diam _____	Mesh Size _____ Diam _____

* Use Data *

Private Well: Domestic Agricultural _____ Industrial _____ Monitoring _____
 Public Well: Community _____ Non Community _____

* Abandonment Information *

Bored or Dug Wells

Casing Removed, Y or N? _____
 If Y, Depth to which casing was removed: _____
 Depth and Type of Fill: _____
 Source of Fill _____
 Bentonite Plugs: From _____ to _____ From _____ to _____

Wells other than Bored Wells

Casing removed, Y or N? _____
 Depth to which casing was removed: _____
 Applicable, depth(s), and type of gravel/sand fill: _____
 Source of gravel or sand: _____
 Cement: From _____ to _____ From _____ to _____


Method of permanently marking location: _____
Installed watertight top
 Suggest setting pump @ approx 280 ft.

Artbill
Sulherd Estates #3
Stafford #648
(Stepaniga Road) Driller's Log

Name of Company/Corporation
 2424
 Address:
 Health

Depth	Description of Formation or Sediment	Remarks
0	10	Red Clay
10	65	Brown Clay
65	72	Soft Brown Rock
72	300	Light Grey Rock

DIAGRAM (NOT TO SCALE)

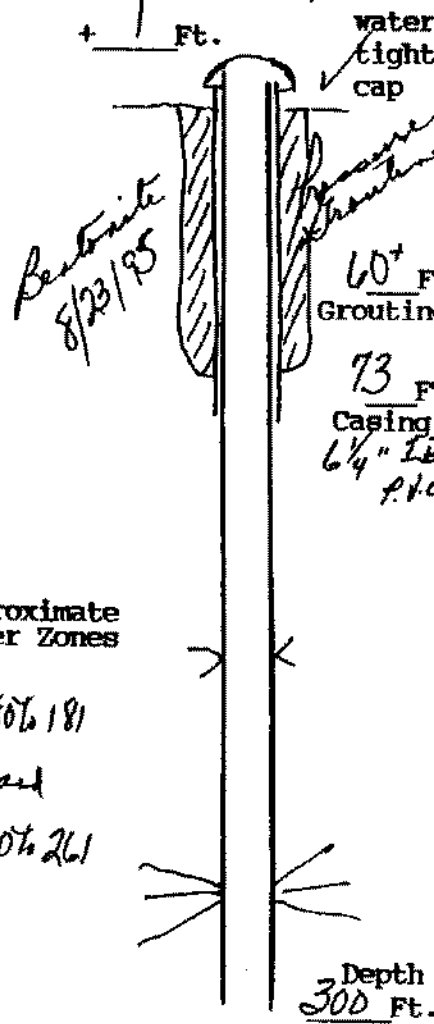

(User additional Sheets if necessary)

I certify that the information contained here is true and that this well was installed and constructed in accordance with the permit and further that the well complies with all applicable state and local regulations, ordinances and laws.

Name JOHN L. DANIELSON, JR., INC.
 Address 4616 HOOD DRIVE
FREDERICKSBURG, VIRGINIA 22408
 Phone (703) 898-6025 / 898-9355

Drillers Signature John L. Danielson, Pres
 Date 8/23/95 Representing JOHN L. DANIELSON, JR., INC.

Virginia Contractors License Number CLASS A 2701 014084A II/H WMC