

272
Lebanon, 22402
F 891-9156

Commonwealth of Virginia
Uniform Water Well Completion Report

Owner Roy J. Rayne
Address 1905 High Pointe Blvd.
Stafford, Va 22554
Phone 720-6736
Location Lakeland Forest # 26 (off 650 #616)

Tax Map ID 27A-26
VDH Permit SWP-95-247
VWCB Permit _____
VWCB ID _____
County STAFFORD
8/4/95 Daniel Josephs
SFF

Well Classification IIIA _____ IIIB IIIC _____ IV _____
* Well Data *

General Information
Drilling Method Chis Rotary
Depth to Bedrock 30
Static Water Level 40'
Well Disinfected (Y or N) _____

Date Completed 4/15/96
Yield 4/10 (GPM)
Stabilized Water Level 460
Disinfectant Used _____

Total Depth of Well 500
Length of Test approx 1 Hr
Natural Flow (Rate) _____
Amount Used _____

Casing
From +1 To 59
Size 6 3/4 Material P.V.C.
Weight/Schedule S.D.R 27

From _____ To _____
Size _____ Material _____
Weight/Schedule _____

From _____ To _____
Size _____ Material _____
Weight/Schedule _____

Gravel Pack
From _____ To _____
Hole size 10" from 0 to 50ft.
Grout _____
From 0 To 50+
Bore Hole Size 10"
Type Bentonite
Method Pressure Grouting

From _____ To _____
Hole size 8 1/2" from 50 to 59ft.
Grout _____
From _____ To _____
Bore Hole Size _____
Type _____
Method _____

From _____ To _____
Hole size 6 1/2" from 59 to 500ft.
Grout _____
From _____ To _____
Bore Hole Size _____
Type _____
Method _____

Water Zones or Screened Intervals
From 100 To 101
Mesh Size _____ Diam _____
From _____ To _____
Mesh Size _____ Diam _____

From _____ To _____
Mesh Size _____ Diam _____

* Use Data *

Private Well: Domestic Agricultural _____ Industrial _____ Monitoring _____
Public Well: Community _____ Non Community _____

* Abandonment Information *

Bored or Dug Wells
Casing Removed, Y or N?: _____
If Y, Depth to which casing was removed: _____
Depth and Type of Fill: _____
Source of Fill: _____
Bentonite Plugs: From _____ to _____ From _____ to _____

Wells other than Bored Wells
Casing removed, Y or N?: _____
Depth to which casing was removed: _____
Applicable, depth(s), and type of gravel/sand fill: _____
Source of gravel or sand: _____
Cement: From _____ to _____ From _____ to _____

Method of permanently marking location:
 Installed watertight top
Suggest setting pump @ approx. 480 ft.

Hand Construction

Roy J. Payne

Lakeland Street #26
Stafford

* Drillers Log *


Depth

Description of Formation or Sediment

Remarks

0	10	Sandy Red Clay
10	20	Miscellaneous Formation/Red
20	30	Miscellaneous Formation/Brown
30	59	Brown Shale
59	500	Blue Granite

DIAGRAM
(NOT TO SCALE)

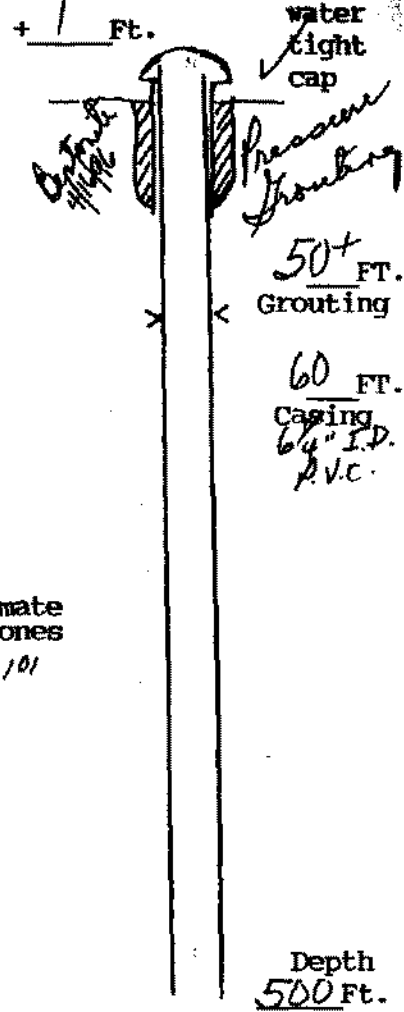

Approximate
Water Zones
100% 101

(User additional Sheets if necessary)

I certify that the information contained here is true and that this well was installed and constructed in accordance with the permit and further that the well complies with all applicable state and local regulations, ordinances and laws.

Name JOHN L. DANIELSON, JR., INC.
 Address 4616 HOOD DRIVE
FREDERICKSBURG, VIRGINIA 22408
 Phone 540 (203) 898-6025 / 898-9355

Drillers Signature *John L. Danielson, Inc.*
 Date 4/16/96 Representing JOHN L. DANIELSON, JR., INC.

Virginia Contractors Licence Number CLASS A 2701 014084A H/H WWC