

Garrett Development Corporation
P.O. Box 2648
Stafford, Va. 22555
559-16172 Fax 659-3449

Commonwealth of Virginia
 Uniform Water Well Completion Report

Owner Garrett Development / Fox Sch
 Address P.O. Box 2648
Stafford, VA 22555
 Phone 659-6172
 Location Lakeland Forest Lot #10 Lakeland Road
19 -> 616 -> 650 -> Lakeland Road

Tax Map ID 27A-10
 VDH Permit SWP-96-402
 VWCB Permit _____
 VWCB ID _____
 County STAFFORD
12/24/96 Roderic B. Wright

Well Classification IIIA _____ IIIB IIIC _____ IV _____
 * Well Data *

SFF

General Information
 Drilling Method Chi Rotary
 Depth to Bedrock 82'
 Static Water Level 40'
 Well Disinfected (Y or N) _____

Date Completed 4/30/97
 Yield 5 (GPM)
 Stabilized Water Level LRD
 Disinfectant Used _____

Total Depth of Well 240'
 Length of Test approx 1 Hr.
 Natural Flow (Rate) _____
 Amount Used _____

Casing
 From 1 1/2 To 82
 Size 6 1/4 Material P.V.C.
 Weight/Schedule SDR 27

From 70 To 200
 Size 4" Material P.V.C.
 Weight/Schedule Sch 40

From 220 To 240
 Size 4" Material P.V.C.
 Weight/Schedule Sch 40

Gravel Pack
 From _____ To _____

From _____ To _____

From _____ To _____

Hole size
10" from 0 to 60 ft.

7 7/8" from 60 to 82 ft.

6 1/2" from 82 to 240 ft.

Grout
 From 0 To 5/5/97
 Bore Hole Size 10"
 Type Bentonite
 Method Pressure Grouting

From _____ To _____
 Bore Hole Size _____
 Type _____
 Method _____

From _____ To _____
 Bore Hole Size _____
 Type _____
 Method _____

Water Zones or Screened Intervals
 From 200 To 220
 Mesh Size 20 Diam 7" (P.V.C.)
 From _____ To _____
 Mesh Size _____ Diam _____

approx water zone
 From 216 To 217
 Mesh Size _____ Diam _____
 From _____ To _____
 Mesh Size _____ Diam _____

From _____ To _____
 Mesh Size _____ Diam _____
 From _____ To _____
 Mesh Size _____ Diam _____

* Use Data *

Private Well: Domestic Agricultural _____ Industrial _____ Monitoring _____
 Public Well: Community _____ Non Community _____

* Abandonment Information *

Bored or Dug Wells
 Casing Removed, Y or N? _____
 If Y, Depth to which casing was removed: _____
 Depth and Type of Fill: _____
 Source of Fill _____
 Bentonite Plugs: From _____ to _____ From _____ to _____

Wells other than Bored Wells
 Casing removed, Y or N? _____
 Depth to which casing was removed: _____
 Applicable, depth(s), and type of gravel/sand fill: _____
 Source of gravel or sand: _____
 Cement: From _____ to _____ From _____ to _____

Method of permanently marking location:
 Installed watertight top
 Suggest setting pump @ approx. 200 ft.
you will encounter 4" casing @ approx 70 ft. rest of 4" casing

Street Development Corp.

Lakeland Forest #10


Stafford

17 -> 616 -> 650 -> Lakeland Road

* Drillers Log *

Depth	Description of Formation or Sediment	Remarks
-------	--------------------------------------	---------

0	10	Red Clay
10	30	Mucaceous formation / Red
30	50	Mucaceous formation / Brown
50	82	Brown Shale { set 4" P.V.C. Well Casing & Screen due to the softness of the formation
82	240	Blue Shale

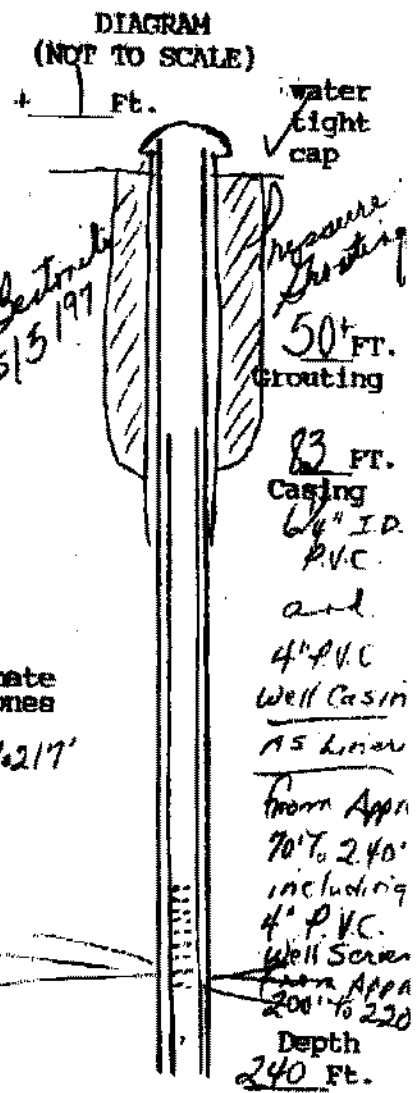

Approximate Water Zones

216 to 217'

(Use additional Sheets if necessary)

I certify that the information contained here is true and that this well was installed and constructed in accordance with the permit and further that the well complies with all applicable state and local regulations, ordinances and laws.

Name JOHN L. DANIELSON, JR., INC.

Address 4616 HOOD DRIVE
FREDERICKSBURG, VIRGINIA 22408

Phone 703 (203) 898-6025 / 898-9355

Drillers Signature John L. Danielson President

Date 7/5/97 Representing JOHN L. DANIELSON, JR., INC.

Virginia Contractors License Number CLASS A 2701 014084A H/H WMC