

Ray Jones  
P.O. Box 507  
Stafford, Va. 22463  
720-8452 FAX 720-8550

Commonwealth of Virginia  
Uniform Water Well Completion Report

Owner Richard Towala  
Address 572 Harrisonville Rd.  
Stafford, Va.  
Phone 720-8453  
Location Long Branch Sect 2 Lot 5  
W6 & Steyeriga Rd.  
Well Classification IIIA  IIIB  IIIC  IV   
\* Well Data \*

Tax Map ID 27D-8 27D-2-5  
VDH Permit SWP-97-7  
VWCB Permit \_\_\_\_\_  
VWCB ID \_\_\_\_\_  
County Stafford  
1/16/97 Rob. Snyder  
SFF

General Information  
Drilling Method Air Rotary  
Depth to Bedrock 50  
Static Water Level \_\_\_\_\_  
Well Disinfected (Y or N) \_\_\_\_\_

Date Completed 5/19/97  
Yield \_\_\_\_\_ (GPM)  
Stabilized Water Level \_\_\_\_\_  
Disinfectant Used \_\_\_\_\_

Total Depth of Well 500'  
Length of Test \_\_\_\_\_  
Natural Flow (Rate) \_\_\_\_\_  
Amount Used \_\_\_\_\_

Casing  
From 1' To 55  
Size 6 1/4" Material P.V.C.  
Weight/Schedule S.D.R. 27

From \_\_\_\_\_ To \_\_\_\_\_  
Size \_\_\_\_\_ Material \_\_\_\_\_  
Weight/Schedule \_\_\_\_\_

From \_\_\_\_\_ To \_\_\_\_\_  
Size \_\_\_\_\_ Material \_\_\_\_\_  
Weight/Schedule \_\_\_\_\_

Gravel Pack  
From \_\_\_\_\_ To \_\_\_\_\_  
Hole size 10" from 0 to 50 ft.  
Grout  
From 0 to 50 6/19/97  
Bore Hole Size 10"  
Type Bentonite  
Method Pressure Drilling

From \_\_\_\_\_ To \_\_\_\_\_  
8 1/2" from 50 to 55 ft.  
From \_\_\_\_\_ To \_\_\_\_\_  
Bore Hole Size \_\_\_\_\_  
Type \_\_\_\_\_  
Method \_\_\_\_\_

From \_\_\_\_\_ To \_\_\_\_\_  
6 1/8" from 55 to 500 ft.  
From \_\_\_\_\_ To \_\_\_\_\_  
Bore Hole Size \_\_\_\_\_  
Type \_\_\_\_\_  
Method \_\_\_\_\_

Water Zones or Screened Intervals  
From \_\_\_\_\_ To \_\_\_\_\_  
Mesh Size \_\_\_\_\_ Diam \_\_\_\_\_  
From \_\_\_\_\_ To \_\_\_\_\_  
Mesh Size \_\_\_\_\_ Diam \_\_\_\_\_

\* Use Data \*  
Private Well: Domestic  Agricultural \_\_\_\_\_ Industrial \_\_\_\_\_ Monitoring \_\_\_\_\_  
Public Well: Community \_\_\_\_\_ Non Community \_\_\_\_\_

\* Abandonment Information \*

Bored or Dug Wells  
Casing Removed, Y or N? \_\_\_\_\_  
If Y, Depth to which casing was removed: \_\_\_\_\_  
Depth and Type of Fill: \_\_\_\_\_  
Source of Fill \_\_\_\_\_  
Bentonite Plugs: From \_\_\_\_\_ to \_\_\_\_\_ From \_\_\_\_\_ to \_\_\_\_\_

Wells other than Bored Wells  
Casing removed, Y or N? \_\_\_\_\_  
Depth to which casing was removed: \_\_\_\_\_  
Applicable, depth(s), and type of gravel/sand fill: \_\_\_\_\_  
Source of gravel or sand: \_\_\_\_\_  
Cement: From \_\_\_\_\_ to \_\_\_\_\_ From \_\_\_\_\_ to \_\_\_\_\_


Method of permanently marking location: \_\_\_\_\_  
Installed watertight top  
Suggest setting pump @ approx. \_\_\_\_\_ ft.

*Regency* ~~Regency~~ *Sowala*  
*Long Beach # 5*  
*Stafford*  
 616 + *Stafford*  
 Drillers Log

*7/10/97*  
*513-00*

Depth Description of Formation or Sediment Remarks

0	10	Red Clay
10	20	Micaceous formation / Red
20	40	Micaceous formation / Brown
40	55	Brown Shale
55	500	Blue Granite

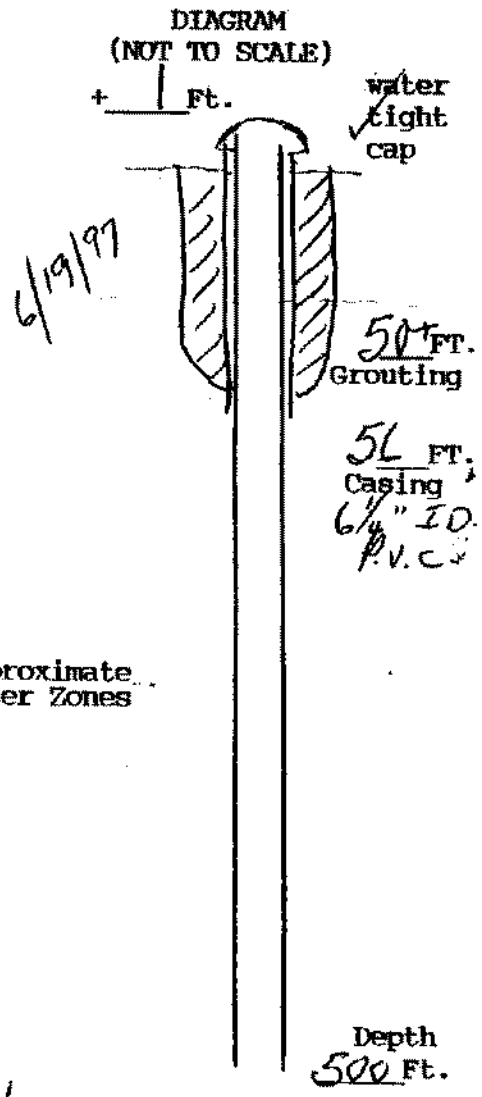

(Use additional Sheets if necessary)

I certify that the information contained here is true and that this well was installed and constructed in accordance with the permit and further that the well complies with all applicable state and local regulations, ordinances and laws.

Name JOHN L. DANIELSON, JR., INC.  
 Address 4616 HOOD DRIVE  
FREDERICKSBURG, VIRGINIA 22408  
 Phone 540 (703) 898-6025 / 898-9355

Drillers Signature *John L. Danielson*  
 Date 6/24/97 Representing JOHN L. DANIELSON, JR., INC.

Virginia Contractors License Number CLASS A 2701 014084A II/H WVC