

Rose Tree Homes Inc
P.O. Box 1033
Spotsylvania, Va. 22553 Commonwealth of Virginia
785-2115 Uniform Water Well Completion Report

Owner Rose Tree Homes Inc / For Sale
 Address P.O. Box 1033
Spotsylvania, Va
 Phone 785-2115
 Location Long Branch Estates #2 (648/ Stefaniga Rd.)

Tax Map ID 27-188-2
 VDH Permit WR-96-208
 WVCB Permit _____
 WVCB ID _____
 County STAFFORD
6/21/96 Karl Radolph
DJC

Well Classification IIIA _____ IIIB _____ IIIC IV _____
 * Well Data *
Second attempt

General Information
 Drilling Method Air Rotary
 Depth to Bedrock 12'
 Static Water Level 25'
 Well Disinfected (Y or N) _____

Date Completed 6/28/96
 Yield 1/2 (GPM)
 Stabilized Water Level 460'
 Disinfectant Used _____

Total Depth of Well 500
 Length of Test approx 1 HR.
 Natural Flow (Rate) _____
 Amount Used _____

Casing
 From +1 To 27
 Size 6" Material A.V.C
 Weight/Schedule S.D.R. 19

From _____ To _____
 Size _____ Material _____
 Weight/Schedule _____

From _____ To _____
 Size _____ Material _____
 Weight/Schedule _____

Gravel Pack
 From _____ To _____

From _____ To _____

From _____ To _____

Hole size
10" from 0 to 20 ft.

8 1/2" from 20 to 26 ft.

6 1/2" from 26 to 500 ft.

Grout
 From 0 To 2' 7/1/96
 Bore Hole Size 10"
 Type Bentonite
 Method Pressure Grouting

From _____ To _____
 Bore Hole Size _____
 Type _____
 Method _____

From _____ To _____
 Bore Hole Size _____
 Type _____
 Method _____

Water Zones or Screened Intervals
 From 40 To 41

From _____ To _____

From _____ To _____

Mesh Size _____ Diam _____

Mesh Size _____ Diam _____

Mesh Size _____ Diam _____

From 60 To 61

From _____ To _____

From _____ To _____

Mesh Size _____ Diam _____

Mesh Size _____ Diam _____

Mesh Size _____ Diam _____

* Use Data *

Private Well: Domestic Agricultural _____ Industrial _____ Monitoring _____
 Public Well: Community _____ Non Community _____

* Abandonment Information *

Bored or Dug Wells
 Casing Removed, Y or N?: _____
 If Y, Depth to which casing was removed: _____
 Depth and Type of Fill: _____
 Source of Fill _____
 Bentonite Plugs: From _____ to _____ From _____ to _____

Wells other than Bored Wells
 Casing removed, Y or N? _____
 Depth to which casing was removed: _____
 Applicable, depth(s), and type of gravel/sand fill: _____
 Source of gravel or sand: _____
 Cement: From _____ to _____ From _____ to _____

Method of permanently marking location:
 Installed watertight top
 Suggest setting pump @ approx. 480 ft.

66 Stefaniga Rd
954267


Rose Tree Homes Inc
For Sale

Long Branch #2
66 Stefania Road
Lefford 648 Drillers Log

Depth Description of Formation or Sediment Remarks

0	12	Red Clay
12	18	Brown Rock
18	500	Light Grey Rock

DIAGRAM
 (NOT TO SCALE)

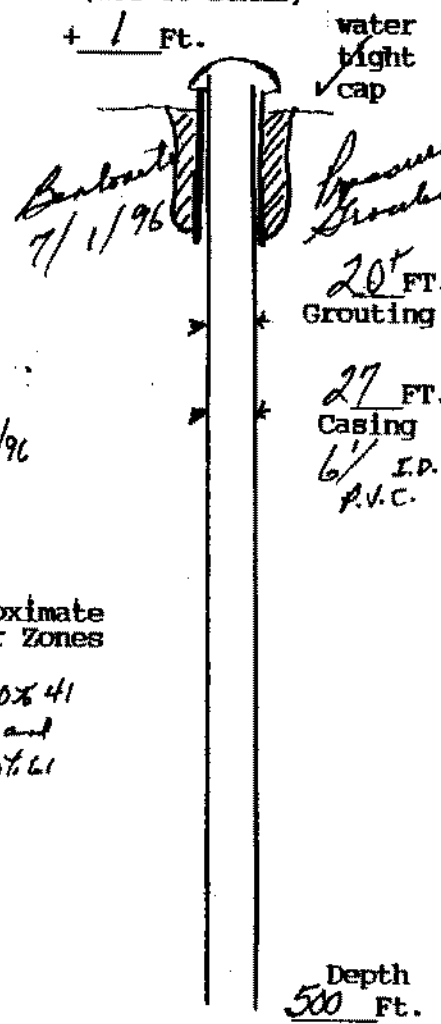

Hydrofractured 4/25/96

Approximate
 Water Zones

40% 41
 and
 60% 61

(User additional Sheets if necessary)

I certify that the information contained here is true and that this well was installed and constructed in accordance with the permit and further that the well complies with all applicable state and local regulations, ordinances and laws.

Name JOHN L. DANIELSON, JR., INC.
 Address 4616 HOOD DRIVE
FREDERICKSBURG, VIRGINIA 22408
 Phone 540 (703) 898-6025 / 898-9355

Drillers Signature [Signature]
 Date 7/1/96 Representing JOHN L. DANIELSON, JR., INC.

Virginia Contractors License Number CLASS A 2701 014084A II/II WWC