

COMMONWEALTH OF VIRGINIA
WATER WELL COMPLETION REPORT

• BWCM No. _____

(Certification of Completion/County Permit)

State Water Control Board
P. O. Box 11143
2111 North Hamilton St.
Richmond, Va. 23230

County/City Stafford

County/City Stamp

• Virginia Plane Coordinates

N _____
E _____

Latitude & Longitude

N _____
W _____

• Topo. Map No. _____

• Elevation _____ ft.

• Formation _____

• Lithology _____

• River Basin _____

• Province _____

• Type Logs _____

• Cuttings _____

• Water Analysis _____

• Aquifer Test _____

• Owner Jody + merwin Shreve

• Well Designation or Number 27-74B

Address 64 Sorrepto Blvd
Hanahan S.C. 29406

Phone 803-744-0940

• Drilling Contractor B. J. Rustis Well Pro

Address RT. 2, Box 1165
Beattion Va

Phone 439-8377

WELL LOCATION: _____ (feet/miles _____ direction) of _____
and _____ (feet/miles _____ direction) of _____
(If possible please include map showing location marked)

Date started 10/29/92 • Date completed 10/29/92 Type rig Air

SWCB Permit _____
County Permit _____

Certification of inspecting official:
This well does _____ does not _____
meet code/low requirements.
S. _____
Date _____

For Office Use

Tax Map I.D. No. 27-74B
WS-91-278

Subdivision Shreve Acres

Section _____
Block _____
Lot 2

Class Well: I _____ IIA _____
IIB _____ IIIA _____ IIIB
IIIC _____ IIID _____ IIIE _____

1. WELL DATA: New Reworked _____ Deepened _____

• Total depth 163 ft.

• Depth to bedrock 116 ft.

• Hole size (also include reamed zones)

• 10 inches from 0 to 126 ft.

• 6 inches from 126 to 163 ft.

• _____ inches from _____ to _____ ft.

• Casing size (I.D.) and material

• 6 inches from 0 to 126 ft.

Material Steel

Wt. per foot 13 or wall thickness 188 in.

• _____ inches from _____ to _____ ft.

Material _____

Wt. per foot _____ or wall thickness _____ in.

• _____ inches from _____ to _____ ft.

Material _____

Wt. per foot _____ or wall thickness _____ in.

• Screen size and mesh for each zone (where applicable)

• _____ inches from _____ to _____ ft.

• Mesh size _____ Type _____

• _____ inches from _____ to _____ ft.

• Mesh size _____ Type _____

• _____ inches from _____ to _____ ft.

• Mesh size _____ Type _____

• _____ inches from _____ to _____ ft.

• Mesh size _____ Type _____

• Gravel pack

• From _____ to _____ ft.

• From _____ to _____ ft.

• Grout

• From 0 to 50 ft. Type Pressure

• From _____ to _____ ft. Type _____

2. WATER DATA • Water temperature _____ of _____

• Static water level (unpumped level-measured) _____ ft.

• Stabilized measured pumping water level 21 ft.

• Stabilized yield 75 gpm after 4 164 hours

Natural Flow: Yes _____ No _____ flow rate _____ gpm

Comment on quality _____

3. WATER ZONES: From _____ To _____

From _____ To _____ From _____ To _____
From _____ To _____ From _____ To _____

4. USE DATA:

Type of use: Drinking Livestock Watering _____
Irrigation _____ Food processing _____ Household
Manufacturing _____ Fire safety _____ Cleaning _____
Recreation _____ Aesthetic _____ Cooling or heating _____
Injection _____ Other _____

• Type of facility: Domestic Public water supply _____

Public institution _____ Farm _____ Industry _____
Commercial _____ Other _____

5. PUMP DATA: Type _____ • Rated H.P. _____

• Intake depth _____ • Capacity _____ at _____ head

6. WELLHEAD: Type well seal _____

Pressure tank _____ gal. Loc. _____
Sample tap _____ Measurement port _____
Well vent _____ Pressure relief valve _____
Gate valve _____ Check valve (when required) _____
Electrical disconnect switch on power supply _____

7. DISINFECTION: Well disinfected _____ yes _____ no _____

Date _____ Disinfectant used _____
Amount _____ Hours used _____

8. ABANDONMENT (where applicable) • yes _____ no _____

Casing pulled yes _____ no _____ not applicable _____
Plugging grout From _____ to _____ material _____

Owner Jay + Mervin Shree


BWCM No. **Completed**

9. State law requires submitting to the Virginia State Water Control Board information about groundwater and wells for every well made in the State intended for water, or any other non-exempt well. This information must be submitted whether the well is completed, on standby, or abandoned. Information required includes: an accurately and completely prepared water well completion report, full data from any aquifer pumping tests, drill cuttings taken at ten foot intervals (unless exemption is secured), the results of any chemical analyses, and copies of any geophysical logs. Quarterly pumpage and use reports are required from owners of public supply and industrial wells. County or State permits to drill may be required in some parts of the state. Some counties require submission of a water well completion report. The Virginia State Health Department requires a water well completion report for public supply wells.

10. DRILLERS LOG (use additional Sheets if necessary)

10. DRILLERS LOG (use additional Sheets if necessary)			11.	12. DIAGRAM OF WELL CONSTRUCTION (with dimensions)
DEPTH (feet)		TYPE OF ROCK OR SOIL	REMARKS	Drilling Time (Min.)
From	To	(color, material, fossils, hardness, etc.)	(water, casing, cavities, broken, core, shot, etc.)	
0	116	Brown soil		
116	165	Brown shale		

Well 165 ft
126 ft casing
50 ft grout
air tight cap

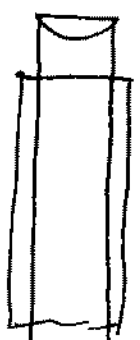

13. Well lot dedicated? Size ft. X ft. Well house?
 Distance to nearest pollutant source ft., Type
 Distance to nearest property line ft., Building ft.

14. WATER SERVICE PIPE: Checked under p. s. i. for
 minutes. Pipe size inches, Material
 Installer
 Date

15. I certify that the information contained herein is true and correct and that this well and/or system has been installed and constructed in accordance with the requirements for well construction as specified in compliance with appropriate county or independent city ordinances and the laws and rules of the Commonwealth of Virginia.

State Water Control Board Regional Offices

Valley Reg. Off.
 116 North Main Street
 P. O. Box 268
 Bridgewater, Va. 22612
 703-628-2595

Southwest Reg. Off.
 408 East Main Street
 P. O. Box 476
 Abingdon, Va. 24210
 703-628-5183

West Central Reg. Off.
 Executive Park
 5312 Peters Creek Road
 Roanoke, Va. 24019
 703-982-7432

Piedmont Reg. Off.
 4010 West Broad Street
 P. O. Box 6616
 Richmond, Va. 23230
 804-257-1006

Tidewater Reg. Off.
 287 Pembroke Office Park
 Suite 310 Pembroke No. 2
 Va. Beach, Va. 23462
 804-499-8742

Northern Virginia Reg. Off.
 5515 Cherokee Avenue
 Suite 404
 Alexandria, Va. 22312
 703-750-9111

Signature Raymond L. Curtis (Seal) Date 10/29/92
 (Well driller or authorized person) License No. 035303