

COMMONWEALTH OF VIRGINIA
WATER WELL COMPLETION REPORT

BWCM No. _____

(Certification of Completion/County Permit)

State Water Control Board
P. O. Box 11143
2111 North Hamilton St.
Richmond, Va. 23230

County/City

Stafford

County/City Stamp

Virginia Plane Coordinates

N _____
E _____
Latitude & Longitude _____
N _____
W _____

• Topo. Map No. _____
• Elevation _____ ft.
• Formation _____
• Lithology _____
• River Basin _____
• Province _____
• Type Logs _____
• Cuttings _____
• Water Analysis _____
• Aquifer Test _____

• Owner John Cox

• Well Designation or Number 17C-3
Address 692 Stelaniga Rd.
Stafford Va 22554
Phone 752-9445

• Drilling Contractor R. L. Curtis Well Co
Address Rt. 2 Box 145
Bealton Va
Phone 703-439-8377

SWCB Permit _____
County Permit _____

Certification of inspecting official:
This well does _____ does not _____
meet code/low requirements.
S. _____
Date _____

For Office Use

Tax Map I.D. No. W5-93-259
Subdivision Chesterwood
Section _____
Block _____
Lot 3
Class Well: I _____ IIA _____
IIB _____ IIIA _____ IIIB
IIIC _____ IIID _____ IIIE _____

WELL LOCATION: _____ (feet/miles _____ direction) of _____
and _____ (feet/miles _____ (direction) of _____
(if possible please include map showing location marked)

Date started 3/17/94 • Date completed 3/17/94 Type rig Air

1. WELL DATA: New Reworked _____ Deepened _____

• Total depth 185 ft.
• Depth to bedrock 32 ft.

• Hole size (also include reamed zones)

- 10 inches from 0 to 50 ft.
- 6 inches from 50 to 185 ft.
- _____ inches from _____ to _____ ft.

• Casing size (I.D.) and material

- 6 inches from 0 to 50 ft.
Material Steel
Wt. per foot 13 or wall thickness 188 in.
- _____ inches from _____ to _____ ft.
Material _____
Wt. per foot _____ or wall thickness _____ in.
- _____ inches from _____ to _____ ft.
Material _____
Wt. per foot _____ or wall thickness _____ in.

• Screen size and mesh for each zone (where applicable)

- _____ inches from _____ to _____ ft.
• Mesh size _____ Type _____
- _____ inches from _____ to _____ ft.
• Mesh size _____ Type _____
- _____ inches from _____ to _____ ft.
• Mesh size _____ Type _____
- _____ inches from _____ to _____ ft.
• Mesh size _____ Type _____

• Gravel pack

- From _____ to _____ ft.
- From _____ to _____ ft.

• Grout

- From 0 to 50 ft. Type Pressure
- From _____ to _____ ft. Type _____

2. WATER DATA • Water temperature _____ of

• Static water level (unpumped level-measured) 18 ft.
• Stabilized measured pumping water level 184 ft.
• Stabilized yield 30 gpm after 4 hours
Natural Flow: Yes _____ No _____ flow rate _____ gpm
Comment on quality _____

3. WATER ZONES: From 162 To 164
From _____ To _____ From _____ To _____
From _____ To _____ From _____ To _____

4. USE DATA:
Type of use: Drinking Livestock Watering _____
Irrigation _____ Food processing _____ Household
Manufacturing _____ Fire safety _____ Cleaning _____
Recreation _____ Aesthetic _____ Cooling or heating _____
Injection _____ Other _____

• Type of facility: Domestic Public water supply _____
Public institution _____ Farm _____ Industry _____
Commercial _____ Other _____

5. PUMP DATA: Type _____ • Rated H.P. _____
• Intake depth _____ • Capacity _____ at _____ head

6. WELLHEAD: Type well seal _____
Pressure tank _____ gal. Loc. _____
Sample tap _____ Measurement port _____
Well vent _____ Pressure relief valve _____
Gate valve _____ Check valve (when required) _____
Electrical disconnect switch on power supply _____

7. DISINFECTION: Well disinfected _____ yes _____ no _____
Date _____ Disinfectant used _____
Amount _____ Hours used _____


8. ABANDONMENT (where applicable) • yes _____ no _____
Casing pulled yes _____ no _____ not applicable _____
Plugging grout From _____ to _____ material _____

Owner John Coy

BWCM No. _____

9. State law requires submitting to the Virginia State Water Control Board information about groundwater and wells for every well made in the State intended for water, or any other non-exempt well. This information must be submitted whether the well is completed, on standby, or abandoned. Information required includes: an accurately and completely prepared water well completion report, full data from any aquifer pumping tests, drill cuttings taken at ten foot intervals (unless exemption is secured), the results of any chemical analyses, and copies of any geophysical logs. Quarterly-pumpage and use reports are required from owners of public supply and industrial wells. County or State permits to drill may be required in some parts of the state. Some counties require submission of a water well completion report. The Virginia State Health Department requires a water well completion report for public supply wells.

10. DRILLERS LOG (use additional Sheets if necessary)			11. Drilling Time (Min.)	12. DIAGRAM OF WELL CONSTRUCTION (with dimensions)
DEPTH (feet)		TYPE OF ROCK OR SOIL		
From	To	(color, material, fossils, hardness, etc.)	(water, casing, cavities, broken, core, shot, (etc.))	
0	32	red soil		Well 185 ft 50 ft casing 50 ft grout air tight cap
32	185	sand stone		

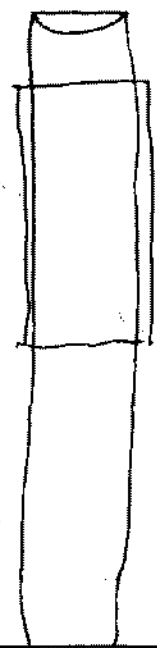

13. Well lot dedicated? _____ Size _____ ft. X _____ ft., Well house? _____
 Distance to nearest pollutant source _____ ft., Type _____
 Distance to nearest property line _____ ft., Building _____ ft.

14. WATER SERVICE PIPE: Checked under _____ p. s. i. for _____
 minutes. Pipe size _____ inches, Material _____
 Installer _____
 Date _____

15. I certify that the information contained herein is true and correct and that this well and/or system has been installed and constructed in accordance with the requirements for well construction as specified in compliance with appropriate county or independent city ordinances and the laws and rules of the Commonwealth of Virginia.

State Water Control Board Regional Offices

Valley Reg. Off.
 116 North Main Street
 P. O. Box 268
 Bridgewater, Va. 22812
 703-828-2593

Southwest Reg. Off.
 408 East Main Street
 P. O. Box 476
 Abingdon, Va. 24210
 703-628-5183

West Central Reg. Off.
 Executive Park
 5312 Peters Creek Road
 Roanoke, Va. 24019
 703-982-7432

Piedmont Reg. Off.
 4010 West Broad Street
 P. O. Box 6616
 Richmond, Va. 23230
 804-257-1006

Tidewater Reg. Off.
 287 Pembroke Office Park
 Suite 310 Pembroke No. 2
 Va. Beach, Va. 23462
 804-499-8742

Northern Virginia Reg. Off.
 5515 Cherokee Avenue
 Suite 404
 Alexandria, Va. 22312
 703-750-9111

Signature Raymond L Curtis (Seal) Date 3/17/94
 (Well owner or authorized person)
 License No. 035303 1A