

**COMMONWEALTH OF VIRGINIA
WATER WELL COMPLETION REPORT**

• SWCM No. _____

(Certification of Completion/County Permit)

Water Control Board
P.O. Box 11143
2111 North Hamilton St.
Richmond, Va. 23230

County/City Stafford

County/City Stamp

SWCB Permit _____
County Permit _____
Certification of inspecting official:
This well does _____ does not _____
meet code/low requirements.
S. _____
Date _____

For Office Use
28-70-A

• Virginia Plane Coordinates
N _____
E _____
Latitude & Longitude _____
N _____
W _____
• Topo. Map No. 183-A
• Elevation _____ ft.
• Formation _____
• Lithology _____
• River Basin _____
• Province _____
• Type Logs D. L.
• Cuttings N. A.
• Water Analysis _____
• Aquifer Test _____

• Owner Mark Doyle
• Well Designation or Number _____
Address Rt 2, Box 2161
Phone Stafford, Va. 22554 659-2592
659-5374
• Drilling Contractor John L. Danielson, Jr., Inc.
Address 4616 Hood Drive
Fredericksburg, Virginia 22401
Phone (703) 898-6025

Tax Map I.D. No. _____
Subdivision _____
Section _____
Block _____
Lot _____
Class Well: I _____, IIA _____
IIB _____, IIIA _____, IIIB
IIC _____, IIID _____, IIIE _____

WELL LOCATION: 6 feet/miles West (direction) of Rts 627 + 651
and 3 feet/miles North (direction) of Rt 627
(If possible please include map showing location marked)
Water rose 3 ft. in 30 min. @ time of installation
24" I.D. casing holds 25.5 gal. of water per foot.
Date started 9/12/85 • Date completed 9/12/85 Type rig Boring Rig


Approximate Drawdown 20 ft.

1. WELL DATA: New Reworked _____ Deepened _____
• Total depth 53 ft.
• Depth to bedrock _____ ft.
• Hole size (Also include reamed zones)
• 39 inches from 0 to 20 ft.
• 29 inches from 20 to 53 ft.
• _____ inches from _____ to _____ ft.
• Casing size (I.D.) and material
• 24 inches from +1 to 53 ft.
Material concrete
Wt. per foot _____ or wall thickness _____ in.
• _____ inches from _____ to _____ ft.
Material _____
Wt. per foot _____ or wall thickness _____ in.
• _____ inches from _____ to _____ ft.
Material _____
Wt. per foot _____ or wall thickness _____ in.
• Screen size and mesh for each zone (where applicable)
• _____ inches from _____ to _____ ft.
• Mesh size _____ Type _____
• _____ inches from _____ to _____ ft.
• Mesh size _____ Type _____
• _____ inches from _____ to _____ ft.
• Mesh size _____ Type _____
• _____ inches from _____ to _____ ft.
• Mesh size _____ Type _____
• Gravel pack
• From _____ to _____ ft.
• From _____ to _____ ft.
• Grout
• From _____ to _____ ft. Type _____
• From _____ to _____ ft. Type _____

2. WATER DATA • Water temperature _____ °F
• Static water level (unpumped level measured) 25 ft.
• Stabilized measured pumping water level 25 ft.
• Stabilized yield 2 gpm after _____ hour
Natural Flow: Yes _____ No flow rate _____ gpm
Comment on quality _____
3. WATER ZONES: From 25 To 40
From _____ To _____ From _____ To _____
From _____ To _____ From _____ To _____
4. USE DATA:
Type of use: Drinking Livestock Watering _____
Irrigation _____ Food processing _____ Household
Manufacturing _____ Fire safety _____ Cleaning _____
Recreation _____ Aesthetic _____ Cooling or heating _____
Injection _____ Other _____
• Type of facility: Domestic Public water supply _____
Public institution _____ Farm _____ Industry _____
Commercial _____ Other _____
5. PUMP DATA: Type _____ • Rated H.P. _____
• Intake depth _____ • Capacity _____ at _____ head
6. WELLHEAD: Type well seal:
Pressure tank _____ gal. Loc. _____
Sample tap _____ Measurement port _____
Well vent _____ Pressure relief valve _____
Gate valve _____ Check valve (when required) _____
Electrical disconnect switch on power supply _____
7. DISINFECTION: Well disinfected _____ yes _____ no _____
Date _____ Disinfectant used _____
Amount _____ Hours used _____
8. ABANDONMENT (where applicable) • yes _____ no _____
Casing pulled yes _____ no _____ not applicable _____
Plugging grout From _____ to _____ material _____
Pump installation through Mark Doyle

Granting
OVER

JOHN L. DANIELSON, JR., INC.
Drilled & Bored Wells
4616 Hood Drive
FREDERICKSBURG, VIRGINIA 22401

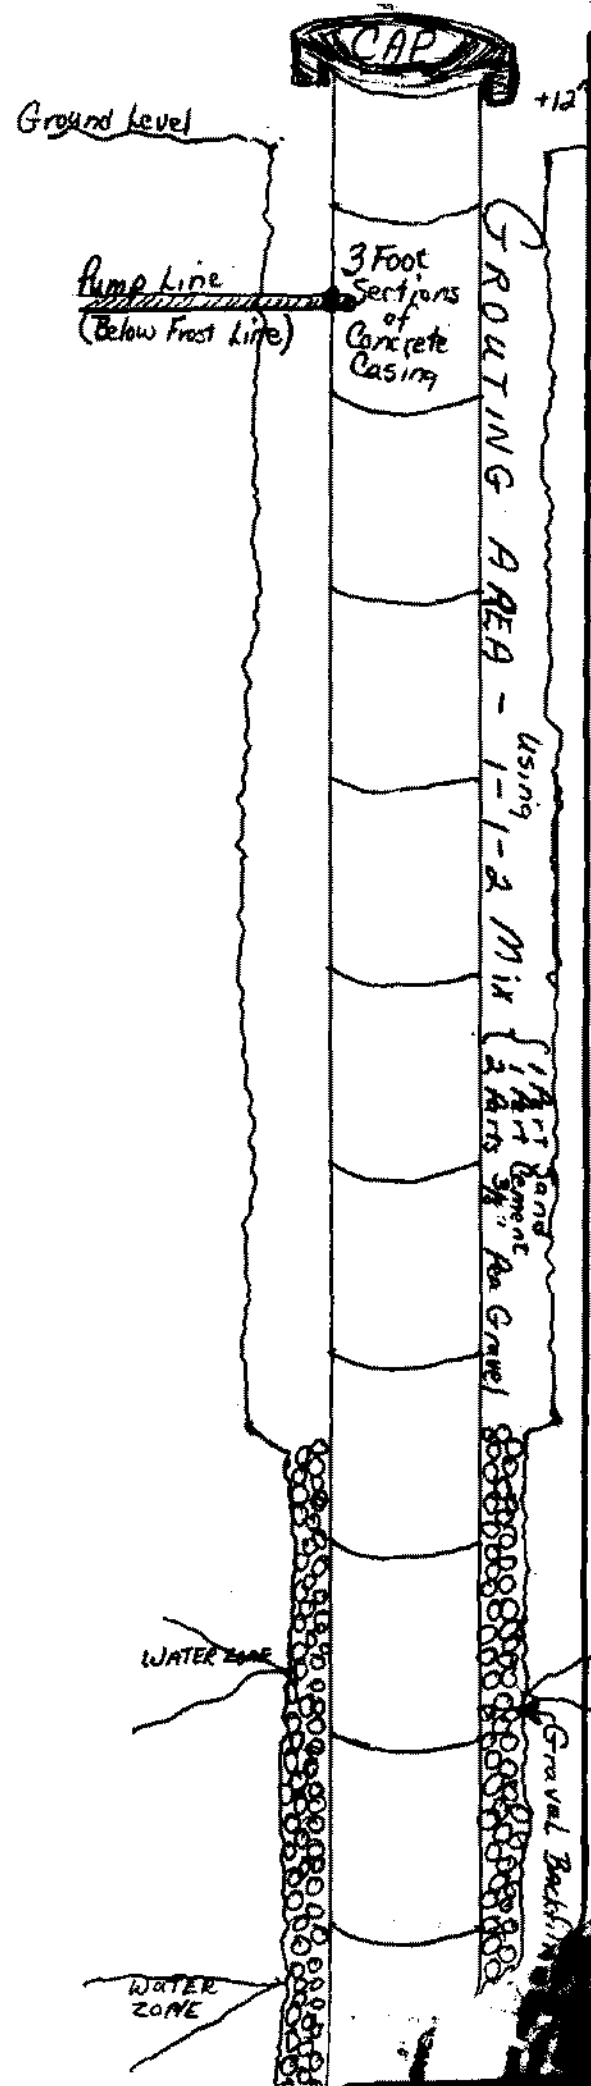

Phone 898-WELL or 898-6025