

**Commonwealth of Virginia  
Uniform Water Well Completion Report**

Benjamin Phipps  
 Owner Benjamin Phipps  
 Address 148 Dog Patch Lane  
Stafford, Va. 22554  
 Phone 659-6046  
 Location 182A 98 Dog Patch Lane  
 Well Classification IIIA IIIB  IIIC IV  
 \* Well Data \*

Tax Map ID 2B-107D  
 VDH Permit 34-94-391  
 VWCB Permit \_\_\_\_\_  
 VWCB ID \_\_\_\_\_  
 County Stafford  
9/19/94 Daniel Jesaitys

**General Information**

Drilling Method <u>Air Rotary</u>	Date Completed <u>9/19/94</u>	Total Depth of Well <u>400</u>
Depth to Bedrock <u>36</u>	Yield <u>25</u> (GPM)	Length of Test <u>approx 1 Hr</u>
Static Water Level <u>50</u>	Stabilized Water Level <u>approx 300</u>	Natural Flow (Rate) _____
Well Disinfected (Y or N) _____	Disinfectant Used _____	Amount Used _____

**Casing**

From <u>+1</u> To <u>60</u>	From _____ To _____	From _____ To _____
Size <u>6 3/4"</u> Material <u>P.V.C.</u>	Size _____ Material _____	Size _____ Material _____
Weight/Schedule <u>SDR 27</u>	Weight/Schedule _____	Weight/Schedule _____

**Gravel Pack**

From _____ To _____	From _____ To _____	From _____ To _____
---------------------	---------------------	---------------------

**Hole size**

<u>10"</u> from <u>0</u> to <u>60</u> ft.	<u>6 1/8"</u> from <u>60</u> to <u>400</u> ft.	" from _____ to _____ ft.
---	--	---------------------------

**Grout**

From <u>0</u> To <u>50 + 9/19/94</u>	From _____ To _____	From _____ To _____
Bore Hole Size <u>10"</u>	Bore Hole Size _____	Bore Hole Size _____
Type <u>Bentonite</u>	Type _____	Type _____
Method <u>Pressure Grouting</u>	Method _____	Method _____

**Water Zones or Screened Intervals**

From <u>210</u> To <u>211</u>	From <u>380</u> To <u>381</u>	From _____ To _____
Mesh Size _____ Diam _____	Mesh Size _____ Diam _____	Mesh Size _____ Diam _____
From <u>265</u> To <u>266</u>	From _____ To _____	From _____ To _____
Mesh Size _____ Diam _____	Mesh Size _____ Diam _____	Mesh Size _____ Diam _____

**\* Use Data \***

Private Well: Domestic  Agricultural \_\_\_\_\_ Industrial \_\_\_\_\_ Monitoring \_\_\_\_\_  
 Public Well: Community \_\_\_\_\_ Non Community \_\_\_\_\_

1 H.P. 76 GPM Red Jacket Submersible  
SN Pump 032 8890  
Motor 032 8891  
10 X 250 Tank

**\* Abandonment Information \***

**Bored or Dug Wells**

Casing Removed, Y or N?: \_\_\_\_\_  
 If Y, Depth to which casing was removed: \_\_\_\_\_  
 Depth and Type of Fill: \_\_\_\_\_  
 Source of Fill \_\_\_\_\_  
 Bentonite Plugs: From \_\_\_\_\_ to \_\_\_\_\_ From \_\_\_\_\_ to \_\_\_\_\_

**Wells other than Bored Wells**

Casing removed, Y or N? \_\_\_\_\_  
 Depth to which casing was removed: \_\_\_\_\_  
 Applicable, depth(s), and type of gravel/sand fill: \_\_\_\_\_  
 Source of gravel or sand: \_\_\_\_\_  
 Cement: From \_\_\_\_\_ to \_\_\_\_\_ From \_\_\_\_\_ to \_\_\_\_\_

Method of permanently marking location: \_\_\_\_\_

Installed watertight top  
 Suggest setting pump @ approx. 380 ft.

Benjamin Phipps

Stafford 48 Dog Patch Lane


630W → L. on #628 → R. on Dog Patch Lane  
Drillers Log

5116  
150 C. OLDE GREENWAY

Depth Description of Formation or Sediment Remarks

0	10	Red Clay
10	36	Brown Clay
36	400	Light Grey Granite

DIAGRAM (NOT TO SCALE)  
+ 1 Ft.

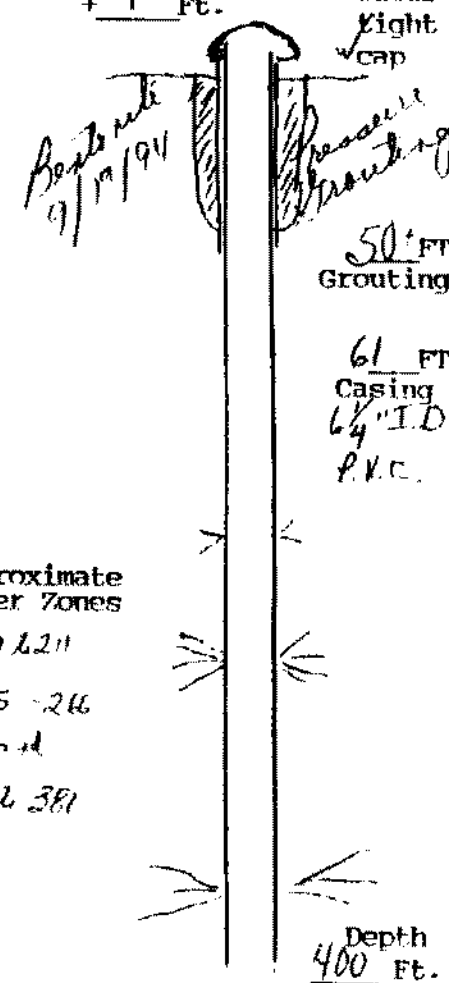

Approximate Water Zones  
 210 to 211  
 265 - 266  
 and  
 380 to 381

(User additional Sheets if necessary)

I certify that the information contained here is true and that this well was installed and constructed in accordance with the permit and further that the well complies with all applicable state and local regulations, ordinances and laws.

Name JOHN L. DANIELSON, JR., INC.  
 Address 4616 HOOD DRIVE  
FREDERICKSBURG, VIRGINIA 22408  
 Phone (703) 898-6025 / 898-9355

Drillers Signature John L. Danielson, Jr.  
 Date 9/13/94 Representing JOHN L. DANIELSON, JR., INC.

Virginia Contractors License Number CLASS A 2701 014084A II/II WVC