

Wyatt
766 Mountain View Rd.
Stafford, VA 22406

Commonwealth of Virginia
Uniform Water Well Completion Report



Owner Jason Wyatt
Address 766 Mtn. View Rd.
Stafford, VA 22406
Phone (540) 659-5270
Location Sparky's Ridge Lot A

Tax Map ID 28-34A
VDH Permit SWP-00-229
VWCB Permit _____
VWCB ID _____
County Stafford

Well Classification IIIA _____ IIIB IIIC _____ IV _____
* Well Data *

General Information

Drilling Method Air Rotary
Depth to Bedrock 125'
Stable Water Level 33'
Well Disinfected (Y or N) N

Date Completed 2/22/01
Yield 10 (GPM)
Stabilized Water Level _____
Disinfectant Used _____

Total Depth of Well 380'
Length of Test 1 hr
Natural Flow (Rate) N
Amount Used _____

Casing From +1 1/2' To 128 1/2'
Size 6 1/2" ID Material PVC
Weight/Schedule 3.491 # per ft.
.250 wall

From _____ To _____
Size 4.5" Material PVC
Weight/Schedule 2.7 # per ft.
.291 wall

From _____ To _____
Size _____ Material _____
Weight/Schedule _____

(100'-200') (200'-240') (240'-280') (280'-320') (320'-360')

Gravel Pack

From _____ To _____

From _____ To _____

From _____ To _____

Hole size

" from _____ to _____ ft.

" from _____ to _____ ft.

" from _____ to _____ ft.

Grout

From 80' To 0
Bore Hole Size 10" x 128 1/2'
Type Bentonite E-2 seal
Method pressure grout from bottom to top

From 128 1/2' To 80'
Bore Hole Size 10" x 128 1/2'
Type case-in + postgrout
Method backfill from drill

From _____ To _____
Bore Hole Size _____
Type _____
Method _____

Water Zones or Screened Intervals

From 200' To 220'
Mesh Size _____ Diam _____
From 320' To 340'
Mesh Size _____ Diam _____

From 240' To 260'
Mesh Size _____ Diam _____
From 360' To 380'
Mesh Size _____ Diam _____

From 280' To 300'
Mesh Size _____ Diam _____
From _____ To _____
Mesh Size _____ Diam _____

* Use Data *

Private Well Domestic Agricultural _____ Industrial _____ Monitoring _____
Public Well Community _____ Non Community _____

* Abandonment Information *

Bored or Cug Wells

Casing Removed, Y or N? _____
Y: Depth to which casing was removed: _____
Depth and type of fill: _____
Source of fill: _____
Bentonite Plugs From _____ to _____ From _____ to _____

Wells other than Bored Wells

Casing removed, Y or N? _____
Depth to which casing was removed: _____
Applicable, depth(s), and type of gravel/sand fill: _____
Source of gravel or sand: _____
Cement: From _____ to _____ From _____ to _____

Method of permanently marking location _____

Installed watertight top

Drillers Log


NOT TO SCALE

Depth

Description of Formation or Sediment

Remarks

0	25'	Brown sandy clay
25'	45'	Tan / brown sandy clay
45'	125'	grey clay
125'	180'	soft grey shale
180'	380'	med. soft

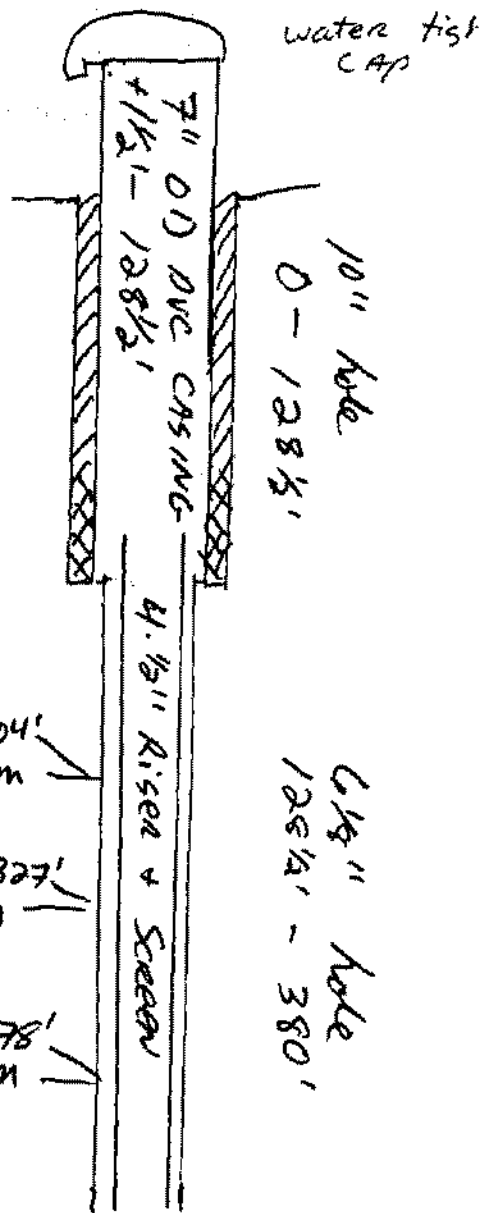

202'-204'
2 GPM

325'-327'
2 GPM

376'-378'
6 GPM

(Use additional Sheets if necessary)

I certify that the information contained here is true and that this well was installed and constructed in accordance with the permit and that the well complies with all applicable state and local regulations, ordinances and laws.

Company ARTESIAN WATER WELLS, INC.
 Address 11412 Gordon Rd
F. BURG VA 22407
 Phone (540) 785-8163

Drillers Signature Wade M. Smith
 Date 2/02/01 Representing A. W. W. J.

Virginia Contractors License Number 2705-046112