

**Commonwealth of Virginia
Uniform Water Well Completion Report**

Owner James M. Cloiskey
 Address P.O. Box 10594
Alexandria VA 22310
 Phone 540-659-5905
 Location Catcher - Lot 7
Rideter Rd. off 7488630
 Well Classification IIIA IIIB IIIC IV
 * Well Data *

Tax Map ID 28-2J
 VDH Permit _____
 VWCB Permit _____
 VWCB ID _____
 County Stafford
7/31/02 Cristina Mardian
05L

General Information

Drilling Method Air Rotary
 Depth to Bedrock _____
 Static Water Level _____
 Well Disinfected (Y or N) _____

Date Completed 4/1/03
 Yield 100 (GPM)
 Stabilized Water Level _____
 Disinfectant Used _____

Total Depth of Well 300'
 Length of Test Approx. 1 Hr.
 Natural Flow (Rate) _____
 Amount Used _____

Casing

From +1 To 66
 Size 6 1/2" Material P.V.C.
 Weight/Schedule S.D.R. 27

From 40 To 260
 Size 4" Material P.V.C.
 Weight/Schedule Sch. 40

From 280 To 300
 Size 4" Material P.V.C.
 Weight/Schedule Sch. 40

Gravel Pack

From _____ To _____

From _____ To _____

From _____ To _____

Hole size

10" from 0 to 50 ft.

7 1/8" from 50 to 65 ft.

6 1/8" from 65 to 300 ft.

Grout

From 0 To 50+
 Bore Hole Size 10"
 Type Bentonite 4/2/03
 Method Pressure Grouting

From _____ To _____
 Bore Hole Size _____
 Type _____
 Method _____

From _____ To _____
 Bore Hole Size _____
 Type _____
 Method _____

Water Zones or Screened Intervals

From 260 To 280
 Mesh Size 020 Diam 4" (P.V.C.)
 From _____ To _____
 Mesh Size _____ Diam _____

From 265 To 266
 Mesh Size _____ Diam _____
 From _____ To _____
 Mesh Size _____ Diam _____

From _____ To _____
 Mesh Size _____ Diam _____
 From _____ To _____
 Mesh Size _____ Diam _____

*** Use Data ***

Private Well: Domestic Agricultural _____ Industrial _____ Monitoring _____
 Public Well: Community _____ Non Community _____

*** Abandonment Information ***

Bored or Dug Wells

Casing Removed, Y or N? _____
 If Y, Depth to which casing was removed: _____
 Depth and Type of Fill: _____
 Source of Fill _____
 Bentonite Plugs: From _____ to _____ From _____ to _____

Wells other than Bored Wells

Casing removed, Y or N? _____
 Depth to which casing was removed: _____
 Applicable, depth(s), and type of gravel/sand fill: _____
 Source of gravel or sand: _____
 Cement: From _____ to _____ From _____ to _____

Method of permanently marking location:

Installed watertight top
 Suggest setting pump @ approx. 240 ft.
Top will encounter 4" casing @ approx. 40 ft.
Suggest keeping centralizer & torque wrenches out of 4" casing.

James M. [unclear]
Castleton #7
Stafford
Kuster Lane
off #648 #630

* Drillers Log *


Depth Description of Formation or Sediment Remarks

0	10	Red Clay
10	20	Brown Clay / Broken Quartz
20	40	Broken Brown Shale
40	65	Brown Shale
65	80	Grey Shale
80	85	Broken Grey Shale
85	200	Grey Shale
200	205	Broken Brown Shale
205	300	Grey Shale

Set 4" P.V.C. Well Casing & Screen - as shown - from approx 40' to 300' due to the softness & fragmentation of the formation. *Ben [unclear] 4/2/03*

Approximate Water Zones
 265 to 266

DIAGRAM (NOT TO SCALE)

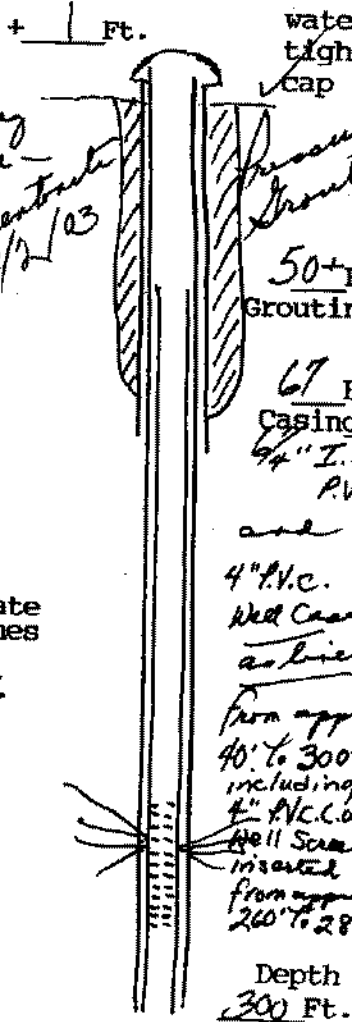

(User additional Sheets if necessary)

I certify that the information contained here is true and that this well was installed and constructed in accordance with the permit and further that the well complies with all applicable state and local regulations, ordinances and laws.

Name JOHN L. DANIELSON, JR., INC.
 Address 4616 HOOD DRIVE
FREDERICKSBURG, VIRGINIA 22408
 Phone 540 (703) 898-6025 / 898-9355

Drillers Signature [Signature]
 Date 4/2/03 Representing JOHN L. DANIELSON, JR., INC.

Virginia Contractors License Number CLASS A 2701 014084A H/H WWC