

**Commonwealth of Virginia  
Uniform Water Well Completion Report**

Address 43 Crater Lane  
Stafford, Va 22554  
Phone 659-5373  
Location Gordon Subdivision Ramoth Church Rd

Tax Map ID 28-103  
VDH Permit W-95-391  
VWCB Permit \_\_\_\_\_  
VWCB ID \_\_\_\_\_  
County STAFFORD

Well Classification IIIA \_\_\_\_\_ IIIB  IIIC \_\_\_\_\_ IV \_\_\_\_\_  
\* Well Data \*

SFF

**General Information**

Drilling Method Air Rotary Date Completed 6/7/96 Total Depth of Well 380'  
Depth to Bedrock 67 Yield 2 (GPM) Length of Test approx 1 Hr  
Static Water Level 40 Stabilized Water Level 340' Natural Flow (Rate) \_\_\_\_\_  
Well Disinfected (Y or N) \_\_\_\_\_ Disinfectant Used \_\_\_\_\_ Amount Used \_\_\_\_\_

**Casing**

From 1' To 67 From 60 To 340 From 360 To 380  
Size 6 1/4" Material P.V.C. Size 4" Material P.V.C. Size 4" Material P.V.C.  
Weight/Schedule SDR 29 Weight/Schedule Sch. 40 Weight/Schedule Sch. 40

**Gravel Pack**

From \_\_\_\_\_ To \_\_\_\_\_ From \_\_\_\_\_ To \_\_\_\_\_ From \_\_\_\_\_ To \_\_\_\_\_

**Hole size**

10" from 0 to 60 ft. 8 1/2" from 60 to 67 ft. 6" from 67 to 380 ft.

**Grout**

From 0 To 65 6/7 From \_\_\_\_\_ To \_\_\_\_\_ From \_\_\_\_\_ To \_\_\_\_\_  
Bore Hole Size 10" Bore Hole Size \_\_\_\_\_ Bore Hole Size \_\_\_\_\_  
Type Bentonite Type \_\_\_\_\_ Type \_\_\_\_\_  
Method Pressure Grouting Method \_\_\_\_\_ Method \_\_\_\_\_

**Water Zones or Screened Intervals**

From 340 To 360 From approx water zone To 101 From \_\_\_\_\_ To \_\_\_\_\_  
Mesh Size 020 Diam 4" P.V.C. Mesh Size \_\_\_\_\_ Diam \_\_\_\_\_ Mesh Size \_\_\_\_\_ Diam \_\_\_\_\_  
From \_\_\_\_\_ To \_\_\_\_\_ From \_\_\_\_\_ To \_\_\_\_\_ From \_\_\_\_\_ To \_\_\_\_\_  
Mesh Size \_\_\_\_\_ Diam \_\_\_\_\_ Mesh Size \_\_\_\_\_ Diam \_\_\_\_\_ Mesh Size \_\_\_\_\_ Diam \_\_\_\_\_

**\* Use Data \***

Private Well: Domestic  Agricultural \_\_\_\_\_ Industrial \_\_\_\_\_ Monitoring \_\_\_\_\_  
Public Well: Community \_\_\_\_\_ Non Community \_\_\_\_\_

**\* Abandonment Information \***

**Bored or Dug Wells**

Casing Removed, Y or N?: \_\_\_\_\_  
If Y, Depth to which casing was removed: \_\_\_\_\_  
Depth and Type of Fill: \_\_\_\_\_  
Source of Fill: \_\_\_\_\_  
Bentonite Plugs: From \_\_\_\_\_ to \_\_\_\_\_ From \_\_\_\_\_ to \_\_\_\_\_

**Wells other than Bored Wells**

Casing removed, Y or N? \_\_\_\_\_  
Depth to which casing was removed: \_\_\_\_\_  
Applicable, depth(s), and type of gravel/sand fill: \_\_\_\_\_  
Source of gravel or sand: \_\_\_\_\_  
Cement: From \_\_\_\_\_ to \_\_\_\_\_ From \_\_\_\_\_ to \_\_\_\_\_

**Method of permanently marking location:**

Installed watertight top  
Suggest setting pump @ approx. 360 ft.

*you will encounter 4" casing @ approx 60 ft.  
Suggest keeping centralizers & torque arrestors out of 4" casing*


Randy Rasack  
 Rex Brown  
 Gordon Sub.  
 Ramoth Church Rd  
 Stafford

\* Drillers Log \*

Depth Description of Formation or Sediment Remarks

0	10	Red Clay
10	30	Micaceous formation / Red
30	50	Micaceous formation / Brown
50	60	Brown Shale
60	380	Blue Shale

Set 4" P.V.C. Well Casing /  
 Screen due to the  
 softness of the  
 formation

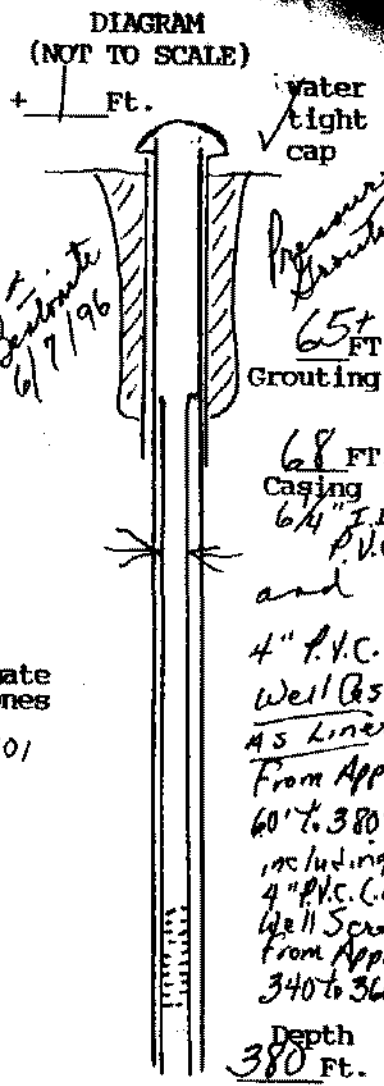

Approximate  
 Water Zones  
 100 to 101



(User additional Sheets if necessary)

I certify that the information contained here is true and that this well was installed and constructed in accordance with the permit and further that the well complies with all applicable state and local regulations, ordinances and laws.

Name JOHN L. DANIELSON, JR., INC.  
 Address 4616 HOOD DRIVE  
FREDERICKSBURG, VIRGINIA 22408  
 Phone 540 (703) 898-6025 / 898-9355

Drillers Signature [Signature]  
 Date 6/7/96 Representing JOHN L. DANIELSON, JR., INC.

Virginia Contractors License Number CLASS A 2701 014084A H/II WWC