

**Commonwealth of Virginia  
Uniform Water Well Completion Report**

Owner Jessie Robey  
 Address P.O. Box 185  
Stafford VA 22555  
 Phone 720 8078  
 Location 1231 Mountain View Road

Tax Map ID 28-36-C  
 VDH Permit W-98-226  
 VWCB Permit \_\_\_\_\_  
 VWCB ID \_\_\_\_\_  
 County Stafford  
4/19/98 John Morley  
SFF

Well Classification IIIA \_\_\_\_\_ IIIB  IIIC \_\_\_\_\_ IV \_\_\_\_\_  
 \* Well Data \*

General Information  
 Drilling Method Air Rotary  
 Depth to Bedrock 78  
 Static Water Level \_\_\_\_\_  
 Well Disinfected (Y or N) \_\_\_\_\_

Date Completed 7/23/98  
 Yield 20 (GPM)  
 Stabilized Water Level \_\_\_\_\_  
 Disinfectant Used \_\_\_\_\_

Total Depth of Well 380'  
 Length of Test approx 1 Hr  
 Natural Flow (Rate) \_\_\_\_\_  
 Amount Used \_\_\_\_\_

Casing  
 From 1 To 78  
 Size 6 1/8 Material P.V.C.  
 Weight/Schedule SDR 27

From 70 To 350  
 Size 4" Material P.V.C.  
 Weight/Schedule Sch. 40

From 370 To 380  
 Size 4" Material P.V.C.  
 Weight/Schedule Sch. 40

Gravel Pack  
 From \_\_\_\_\_ To \_\_\_\_\_

From \_\_\_\_\_ To \_\_\_\_\_

From \_\_\_\_\_ To \_\_\_\_\_

Hole size  
10" from 0 to 50 ft.

7 7/8" from 50 to 78 ft.

6 1/8" from 78 to 380 ft.

Grout  
 From 0 To 50'

From \_\_\_\_\_ To \_\_\_\_\_

From \_\_\_\_\_ To \_\_\_\_\_

Bore Hole Size 10"

Bore Hole Size \_\_\_\_\_

Bore Hole Size \_\_\_\_\_

Type Bentonite

Type \_\_\_\_\_

Type \_\_\_\_\_

Method Pressure Grouting

Method \_\_\_\_\_

Method \_\_\_\_\_

Water Zones or Screened Intervals

approx water zone

From 350 To 370

From 350 To 352

From \_\_\_\_\_ To \_\_\_\_\_

Mesh Size 10/16 Diam 4" (P.V.C.)

Mesh Size \_\_\_\_\_ Diam \_\_\_\_\_

Mesh Size \_\_\_\_\_ Diam \_\_\_\_\_

From \_\_\_\_\_ To \_\_\_\_\_

From \_\_\_\_\_ To \_\_\_\_\_

From \_\_\_\_\_ To \_\_\_\_\_

Mesh Size \_\_\_\_\_ Diam \_\_\_\_\_

Mesh Size \_\_\_\_\_ Diam \_\_\_\_\_

Mesh Size \_\_\_\_\_ Diam \_\_\_\_\_

\* Use Data \*

Private Well: Domestic  Agricultural \_\_\_\_\_ Industrial \_\_\_\_\_ Monitoring \_\_\_\_\_  
 Public Well: Community \_\_\_\_\_ Non Community \_\_\_\_\_

\* Abandonment Information \*

Bored or Dug Wells  
 Casing Removed, Y or N? \_\_\_\_\_  
 If Y, Depth to which casing was removed: \_\_\_\_\_  
 Depth and Type of Fill: \_\_\_\_\_  
 Source of Fill \_\_\_\_\_  
 Bentonite Plugs: From \_\_\_\_\_ to \_\_\_\_\_ From \_\_\_\_\_ to \_\_\_\_\_

Wells other than Bored Wells  
 Casing removed, Y or N? \_\_\_\_\_  
 Depth to which casing was removed: \_\_\_\_\_  
 Applicable, depth(s), and type of gravel/sand fill: \_\_\_\_\_  
 Source of gravel or sand: \_\_\_\_\_  
 Cement: From \_\_\_\_\_ to \_\_\_\_\_ From \_\_\_\_\_ to \_\_\_\_\_

Method of permanently marking location:  
 Installed watertight top  
 Suggest setting pump @ approx. 340 ft.

Jessie Roby

1231 Mountain View Rd

Stafford

\* Drillers Log \*

Depth Description of Formation or Sediment Remarks


0	10	Red Clay
10	30	Mucaceous formation/Red
30	50	Mucaceous formation/Brown
50	78	Brown Shale
78	380	Blue Shale

Set 4" P.V.C. Well Casing & Screen - as liner due to its softness of the formation



Approximate Water Zones

350 to 352

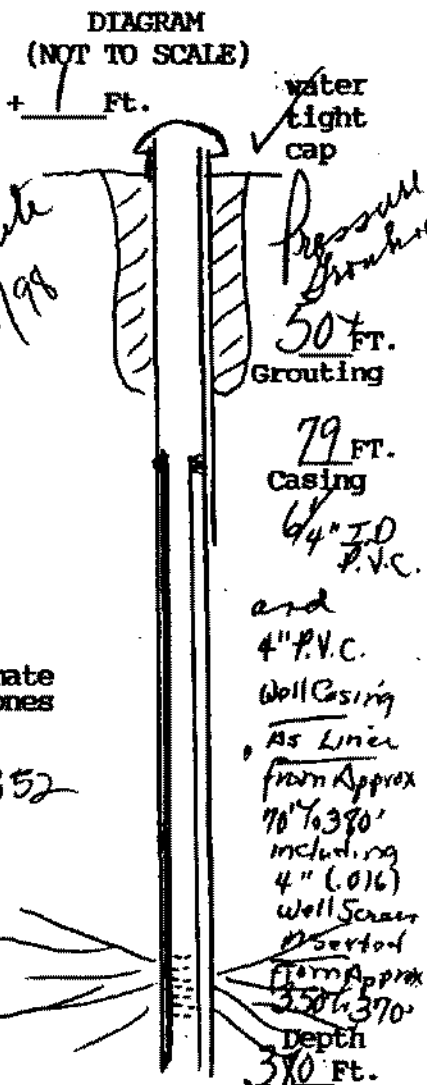

(Use additional Sheets if necessary)

I certify that the information contained here is true and that this well was installed and constructed in accordance with the permit and further that the well complies with all applicable state and local regulations, ordinances and laws.

Name JOHN L. DANIELSON, JR., INC.

Address 4616 HOOD DRIVE  
FREDERICKSBURG, VIRGINIA 22408

Phone 540 (703) 898-6025 / 898-9333

Drillers Signature John L. Danielson, Jr.

Date 7/28/98 Representing JOHN L. DANIELSON, JR., INC.

Virginia Contractors License Number CLASS A 2701 014084A H/H WVC