

**Commonwealth of Virginia
Uniform Water Well Completion Report**

Owner William Armstrong
 Address 59 Wood Road
Stafford Va 22554
 Phone 659-2997
 Location 59 Wood Road (off #627)
1828
 Well Classification IIIA IIIB IIIC IV
 * Well Data *

Tax Map ID 28-52F (Part of)
 VDH Permit WS-93-119
 VWCB Permit _____
 VWCB ID _____
 County Stafford
8/17/93 Robert Snyder
8/17/93 F. T. Thompson

General Information

Drilling Method Air Rotary
 Depth to Bedrock 65
 Static Water Level 40'
 Well Disinfected (Y or N) _____

Date Completed 12/1/93
 Yield 6 (GPM)
 Stabilized Water Level 260'
 Disinfectant Used _____

Total Depth of Well 300'
 Length of Test 1 Hr.
 Natural Flow (Rate) _____
 Amount Used _____

Casing

From +1 To 65
 Size 6 1/4 Material P.V.C.
 Weight/Schedule SDR 27

From _____ To _____
 Size _____ Material _____
 Weight/Schedule _____

From _____ To _____
 Size _____ Material _____
 Weight/Schedule _____

Gravel Pack

From _____ To _____

From _____ To _____

From _____ To _____

Hole size

10 1/2" from 0 to 60 ft.

8 1/2" from 60 to 65 ft.

6 1/2" from 65 to 300 ft.

Grout

From 0 To 60 12/1/93

From _____ To _____

From _____ To _____

Bore Hole Size 10 1/4"

Bore Hole Size _____

Bore Hole Size _____

Type Bentonite

Type _____

Type _____

Method Pressure Grouting

Method _____

Method _____

Water Zones or Screened Intervals

From 260 To 261

From _____ To _____

From _____ To _____

Mesh Size _____ Diam _____

Mesh Size _____ Diam _____

Mesh Size _____ Diam _____

From _____ To _____

From _____ To _____

From _____ To _____

Mesh Size _____ Diam _____

Mesh Size _____ Diam _____

Mesh Size _____ Diam _____

*** Use Data ***

Private Well: Domestic Agricultural _____ Industrial _____ Monitoring _____
 Public Well: Community _____ Non Community _____

*** Abandonment Information ***

Bored or Dug Wells

Casing Removed, Y or N? _____
 If Y, Depth to which casing was removed: _____
 Depth and Type of Fill: _____
 Source of Fill _____
 Bentonite Plugs: From _____ to _____ From _____ to _____

Wells other than Bored Wells

Casing removed, Y or N? _____
 Depth to which casing was removed: _____
 Applicable, depth(s), and type of gravel/sand fill: _____
 Source of gravel or sand: _____
 Cement: From _____ to _____ From _____ to _____


Method of permanently marking location: _____
 Installed watertight top
 Suggest setting pump @ approx. 280 ft.

William Armstrong
59 Wood Road
Stafford
 6/1/27

* Drillers Log *

Depth	Description of Formation or Sediment	Remarks
0	10	Red Clay
10	30	Micaceous formation / Red
30	50	Micaceous formation / Brown
50	65	Brown Shale
65	300	Blue Granite

DIAGRAM
(NOT TO SCALE)

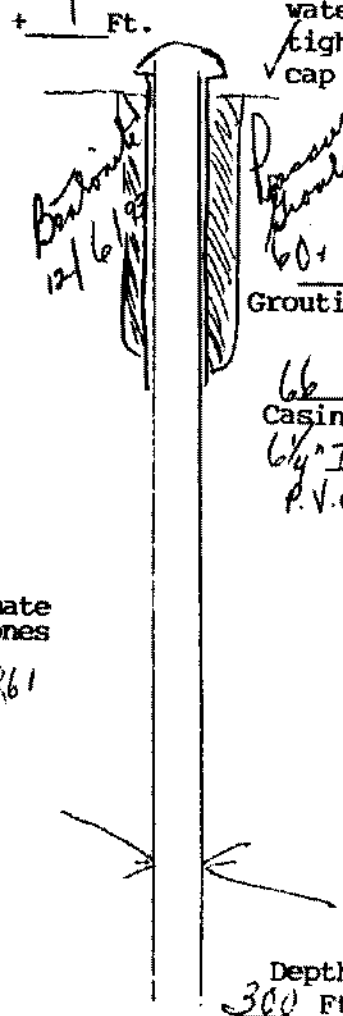

Approximate
Water Zones
260 to 261

(User additional Sheets if necessary)

I certify that the information contained here is true and that this well was installed and constructed in accordance with the permit and further that the well complies with all applicable state and local regulations, ordinances and laws.

Name JOHN L. DANIELSON, JR., INC.
 Address 4616 HOOD DRIVE
FREDERICKSBURG, VIRGINIA 22408
 Phone (703) 898-6025 / 898-9355

Drillers Signature John L. Danielson, Jr.
 Date 12/6/13 Representing JOHN L. DANIELSON, JR., INC.

Virginia Contractors License Number CLASS A 2701 014084A H/H WWC